
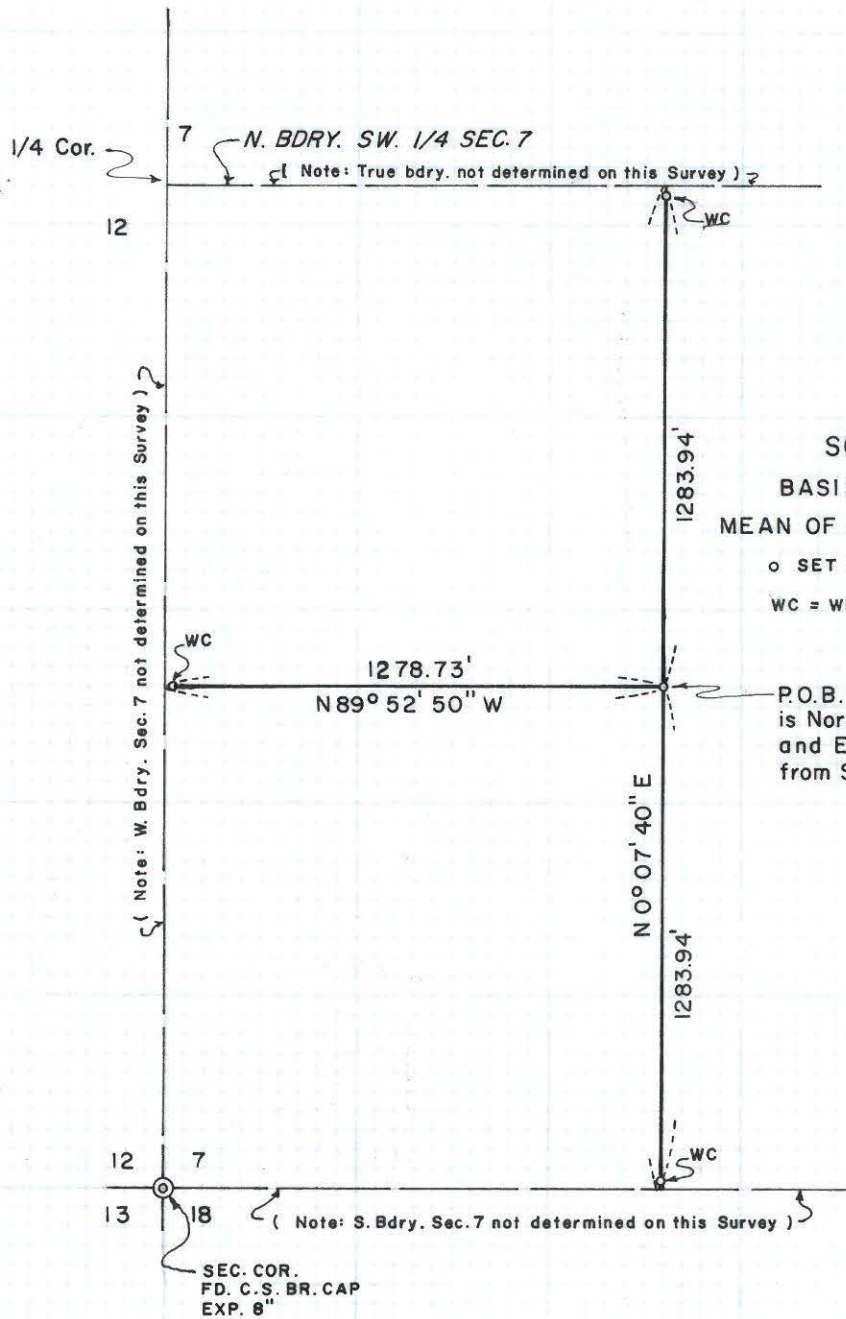


5522

5522

SURVEY FOR:  
**R.C. MINNICK**

LOCATED IN THE SW. 1/4, SECTION 7,  
T. 35 S. R. 2 W., W.M.  
BY: MARK E. BOYDEN  
DEC. 31, 1973

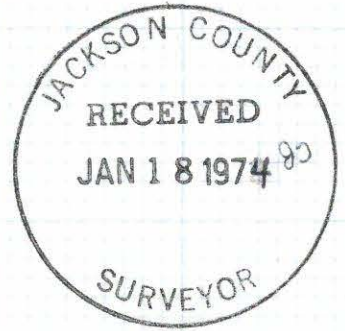

SCALE 1" = 500'

BASIS OF BEARINGS:  
MEAN OF 8 SOLAR OBSERVATIONS  
o SET 3/4" x 24" IRON PIN EXP. 2"-3"  
WC = WITNESS CORNER

REGISTERED  
PROFESSIONAL  
LAND SURVEYOR

*Mark E. Boyden*  
OREGON  
NOV. 9, 1951  
MARK E. BOYDEN  
281

5522

SURVEY NARRATIVE TO COMPLY WITH O.R.S. 209.250

FOR: R. C. Minnick  
Box 306  
Ouray, Colorado, 81427

PURPOSE: To set control monuments and prepare two metes and bounds descriptions for property in the Westerly portion of the Southwest Quarter of Section 7, T35SR2W, W.M.

PROCEDURE: Utilizing a one-second theodolite, an electronic measuring instrument and chain, enclosed the subject tracts by random traverse.

No positive evidence could be found of the West Quarter corner of said Section 7.

From said data, set the additional property corner and witness corners at positions as shown on the map to accompany this report.

December 31, 1973

