

5537  
3087

FOUND 3/4" IRON PIPE

S 89° 54' W (RECORD)

217.77' N 89° 54' 00" E 212.77'

N 00° 33' 00" W 162.28'

85.00'

25'

30'

S 00° 33' 00" E 111.11'

PIERCE ROAD (REC. 662.0')

FOUND SPIKE

WEST 30.00'

78.18' WEST 83.18'

54.02' S 25° 11' 22" W

S 88° 54' 15" W 110.87'

FOUND 1/2 IRON PIPE

FOUND 3/4" IRON PIPE

FOUND 3/4" IRON PIPE

FOUND 1" IRON PIPE

47.71'

30'

25'

MS. 417.94'



465.82'

(REC. 418.0')

WEST 25.00'

N 00° 33' 00" W 418.42' MEAS.

FOUND SPIKE - N.E. CORNER  
BLOCK 9, PIERCE SUBDIVISION PER SURVEY NO. 901

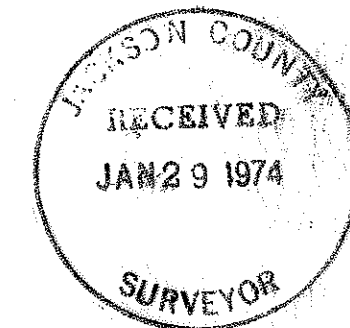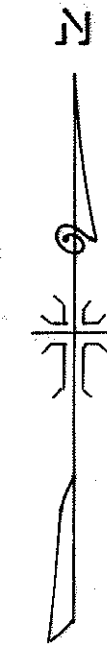

MAP OF SURVEY  
LOCATED IN  
WEST 1/2 OF SECTION 21, T. 37 S., R. 1 W., W.M.  
JACKSON COUNTY OREGON  
FOR  
WILLIAM T. CLARK

J. A. HOFFBUHR, REG. L.S., MEDFORD, OREGON  
SCALE: 1" = 50' MAY 2, 1973  
BASIS OF BEARING - R/S NO. 901  
o = SET 5/8" X 24" IRON REINFORCING PIN

REGISTERED  
PROFESSIONAL  
LAND SURVEYOR

*J. A. Hoffbuh*  
OREGON  
NOV. 7, 1947  
J. A. HOFFBUHR  
222

5537

SURVEY NARRATIVE TO COMPLY WITH PARAGRAPH 209.250  
OREGON REVISED STATUTES

SURVEY FOR: William T. Clark  
545 Pierce Road  
Medford, Oregon

LOCATION: Tract situated in the West One Half (1/2), Section 21,  
Township 37 South, Range 1 West, Willamette Meridian,  
Jackson County, Oregon.

PURPOSE: To locate, monument, and describe the tract as shown  
on the map accompanying this narrative.

PROCEDURE: Located property corners set as per Recorded Survey  
No. 901. Set additional property corners as shown on the attached map  
using the control shown.

Basis of Bearings--Recorded Survey No. 901.

January 25, 1974

J. A. Hoffbuhr  
Professional Land Surveyor

