

SURVEY NARRATIVE TO COMPANY WITH PARAGRAPH 209.250
OREGON REVISED STATUTES

SURVEY FOR: D'Anjou Corporation
Attn. Mr. Frank J. Van Dyke
110 East 6th.
Medford, Oregon

LOCATION: Tract situated in Sections 13 and 24, Township 39 South,
Range 1 East, Willamette Meridian, Jackson County,
Oregon.


PURPOSE: To locate, monument, and describe the tract as shown on
the attached map using the fence lines as they have
existed for many years past. The owners intend to
clear title to the tract described.

PROCEDURE: Located the northwest and northeast corner of Donation
Land Claim No. 54. Located property pins as per Recorded Survey No.
2213, and set additional property pins as shown on the map accompanying
this narrative, on the fence lines as they existed at the time of the
survey.

Basis of Bearings--Recorded Survey No. 2213.

January 29, 1974

J. A. Hoffbuhr
Professional Land Surveyor

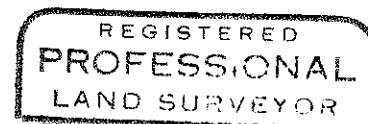

J. A. Hoffbuhr

