

5593

FD. 1/4 COR.
1" IRON PIPE

FD. SECTION COR.
BRASS DISC./CONC.

1326.815' (REC. 1327.02') N 89° 36' 00" E 2653.63' (REC. 2654.04') 1326.815' (REC. 1327.02')

E 1/16
SET 5/8" IRON PIN

RE: R/S No. 1292



EXISTING E
RILEY RD.

1/16 LINE S 00° 03' 50" E 412.50'

5.0'

WITNESS CORNER

N 89° 56' 10" E 363.00'

231.00'


S 00° 03' 50" E 231.00'

25.00'

WITNESS CORNER

S 89° 56' 10" W 363.00'

5.0'

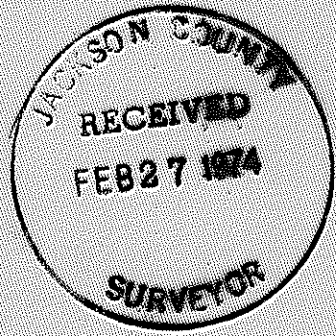

MAP OF SURVEY
LOCATED IN
N.E. 1/4, SEC. 14, T.36S, R.1W, WM.
JACKSON COUNTY, OREGON
FOR
EAGLE POINT SCHOOL DISTRICT No. 9

REGISTERED
PROFESSIONAL
LAND SURVEYOR

J. A. HOFFBUHR, REG. L.S., MEDFORD, OREGON
SCALE: 1" = 100' JANUARY 30, 1974
BASIS OF BEARING R/S No. 1292
° = SET 5/8" x 24" IRON REINFORCING PIN

J. A. Hoffbuhr

OREGON
NOV. 7, 1947
J. A. HOFFBUHR
222

5593

SURVEY NARRATIVE TO COMPLY WITH PARAGRAPH 209.250
OREGON REVISED STATUTES

SURVEY FOR: Eagle Point School District No. 9
240 Main E.
Eagle Point, Oregon


LOCATION: Tract situated in the Northeast One Quarter (1/4),
of Section 14, Township 36 South, Range 1 West,
Willamette Meridian, Jackson County, Oregon.

PURPOSE: To survey and monument that tract as shown on the
map accompanying this narrative as requested by
client.

PROCEDURE: Located the Northeast corner of Section 14, and the
North One Quarter (1/4) corner of Section 14, as per Recorded Survey
No. 1292, by traversing, and set the East One-Sixteenth (1/16) corner
as shown on the map. The record bearing was used for the East One-
Sixteenth line and 5/8 inch iron pins were set at property corners
using record distances for control.

Basis of Bearings--Recorded Survey No. 1292.

February 12, 1974

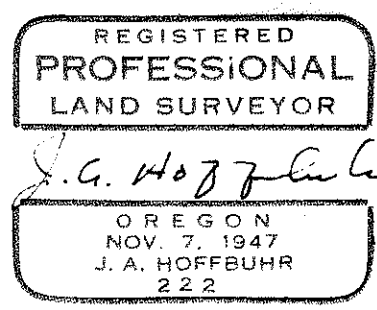

J. A. Hoffbuhr
Professional Land Surveyor