
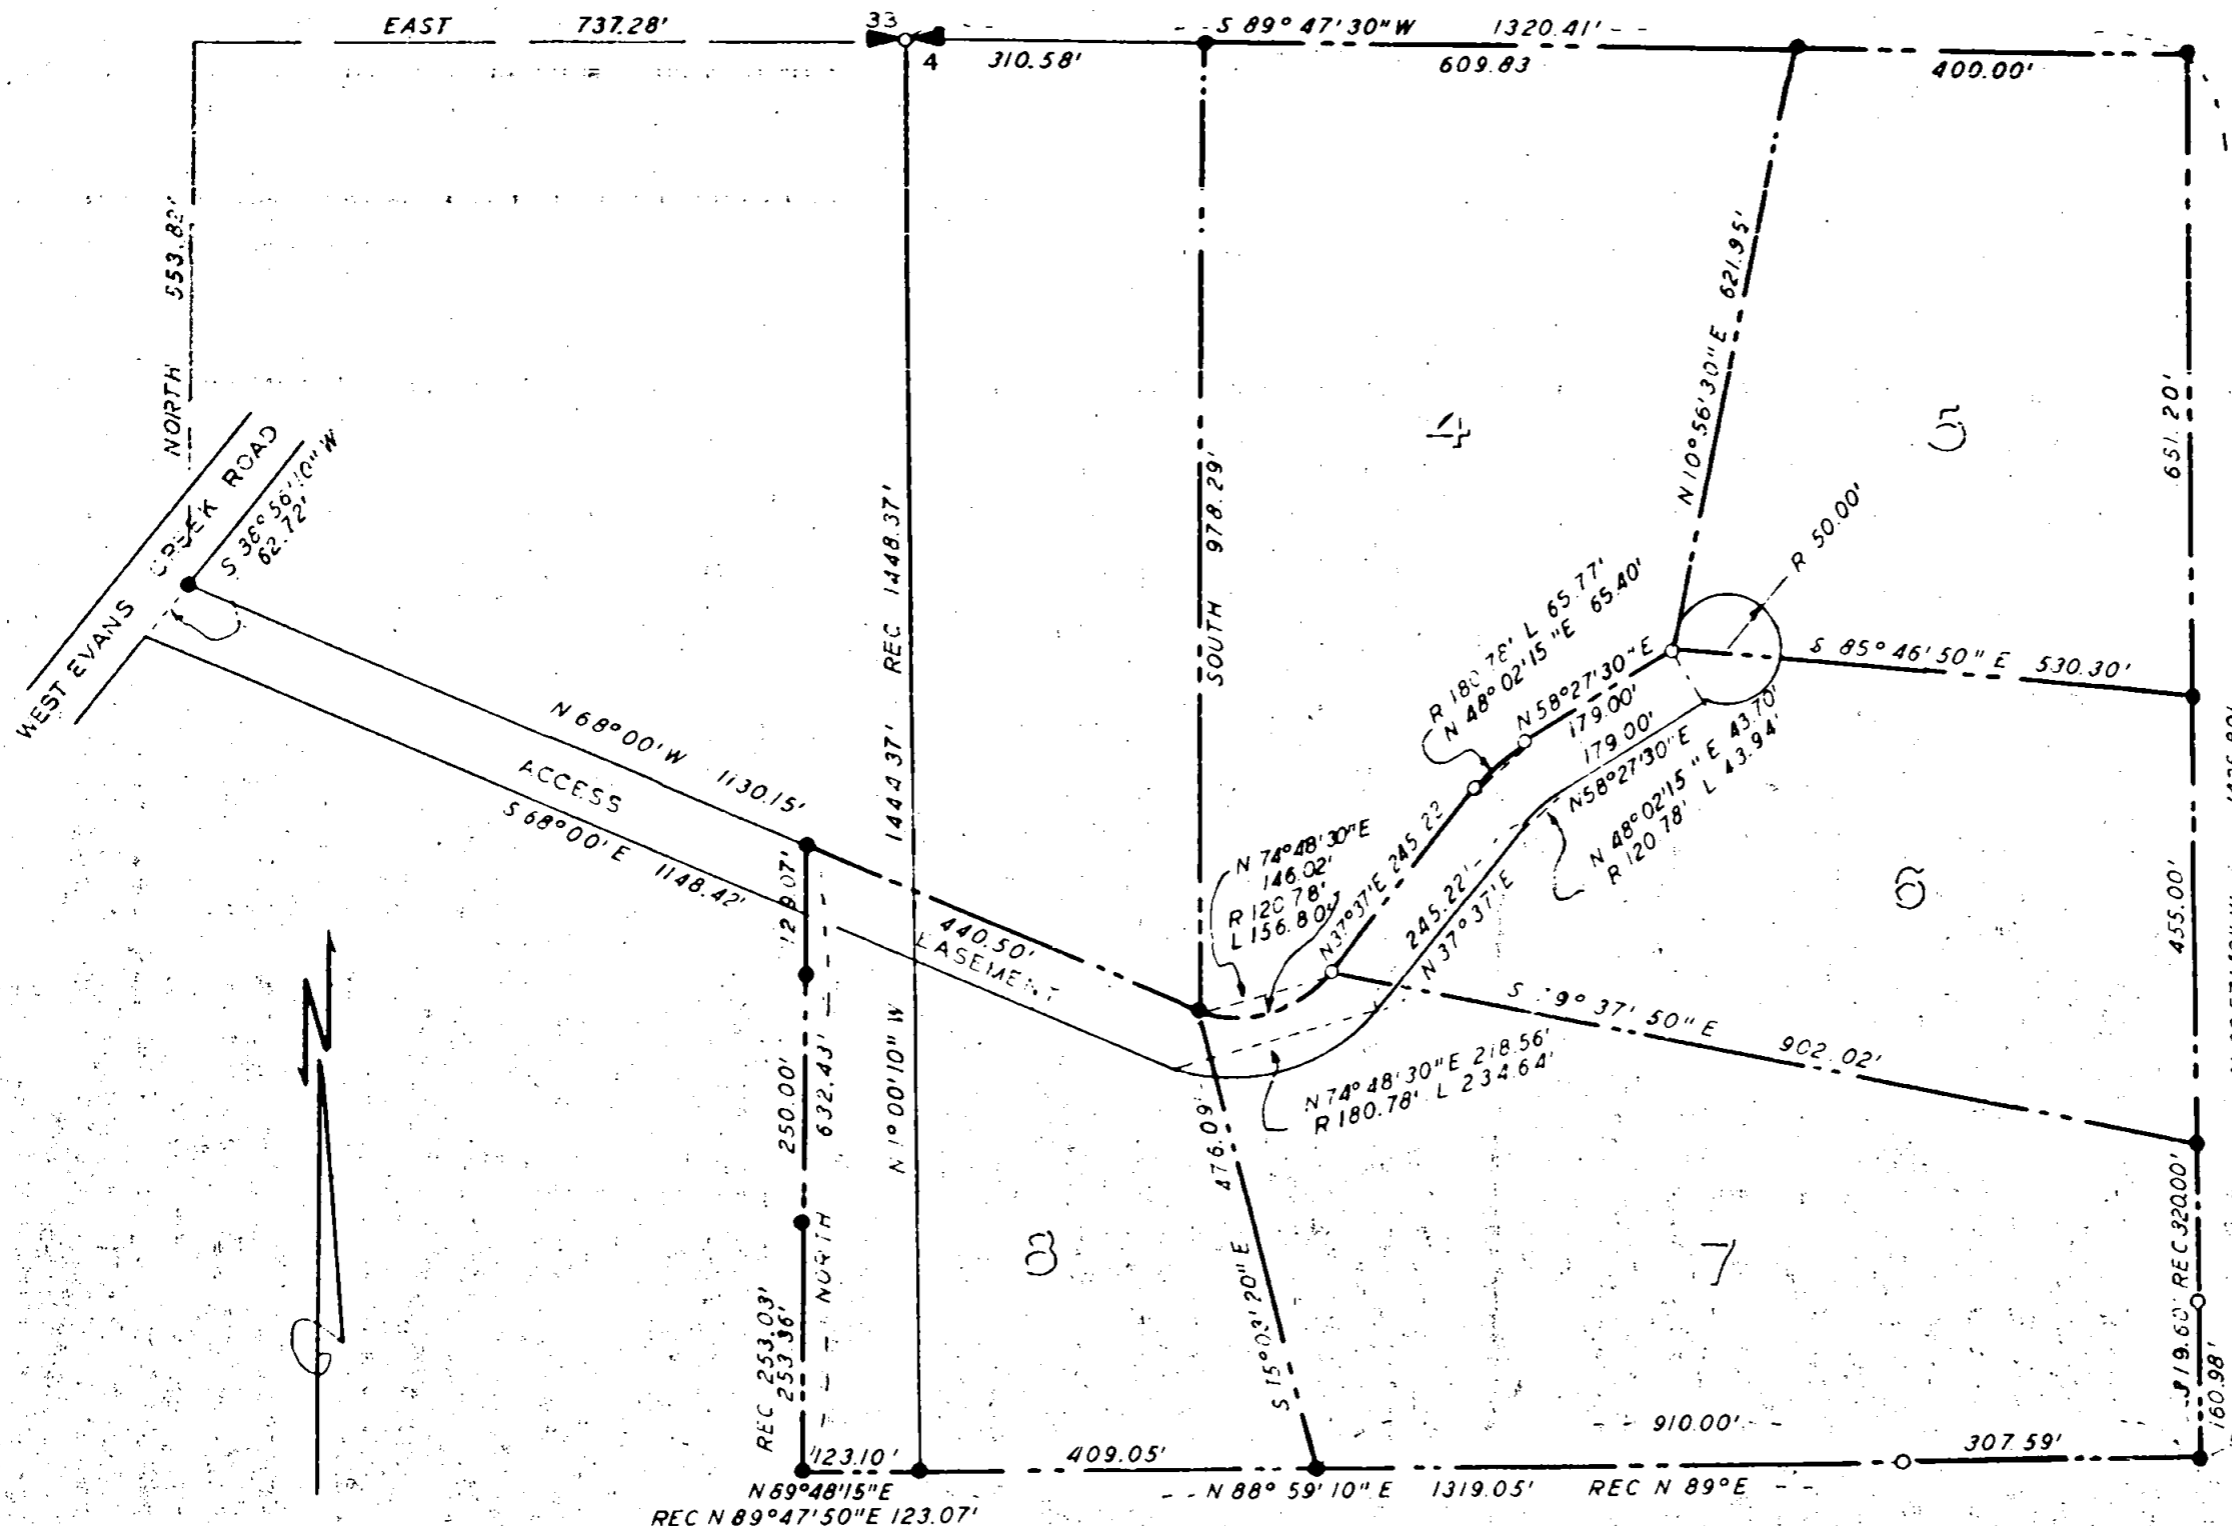


5622

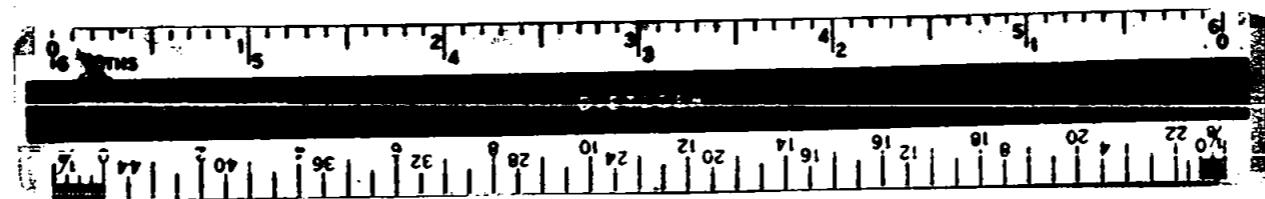

BEARINGS FROM R S 3766  
 ● FOUND 5/8" IRON ROD  
 ○ SET 5/8" X 24" IRON ROD

REGISTERED  
 PROFESSIONAL  
 LAND SURVEYOR  
*G. W. Plumb*  
 OREGON  
 JULY 12, 1968  
 G. W. PLUMB  
 867

JACKSON COUNTY  
 RECEIVED  
 APR 11 1974  
 SURVEYOR

PROPERTY SURVEY  
 SITUATE IN  
 N 1/2 SEC 4 T 35 S R 4 W WM  
 JACKSON COUNTY OREGON  
 G W PLUMB LAND SURVEYOR  
 MEDFORD OREGON 30 MAR 1974

5622

Survey for Richard P. Faltersack  
275 Fourth Street  
Gold Hill, Oregon 97525

Survey by G. W. Plumb  
P. O. Box 904  
Medford, Oregon 97501

Location N $\frac{1}{2}$  Sec. 4, T. 35 S., R. 4 W. W.M., Jackson County, Oregon.

Section 4 was subdivided as shown in Registered Survey Number 5502, Jackson County, Oregon. Minor revisions are shown on the accompanying map; the map for R. S. 5502 was drawn from an incorrect calculation sheet.

5/8 inch x 24 inch iron rods were set as shown on the accompanying map.

30 March 1974

REGISTERED  
PROFESSIONAL  
LAND SURVEYOR

*G. W. Plumb*

OREGON  
JULY 12, 1968  
G. W. PLUMB  
862

JACKSON COUNTY  
RECEIVED  
APR 11 1974  
SURVEYOR

S4 T35S R4W