

5835

REGISTERED
PROFESSIONAL
LAND SURVEYOR

J. G. Hoffbuhr
OREGON
NOV 7 1947
J. A. HOFFBUHR
222

MAP OF SURVEY
LOCATED IN
D.L.C. NO. 84, IN SEC. 36, T. 37 S., R. 2 W., W.M.
JACKSON COUNTY, OREGON
FOR
DOUGLAS PICKELL
J. A. HOFFBUHR, REG. L.S., MEDFORD, OREGON
SCALE: 1"=100'
BASIS OF BEARING— R/S NO. 496
O=SET 5/8" x 24" IRON REINFORCING PIN

JACKSON COUNTY
RECEIVED
MAY 10 1974
SURVEYOR

S.E. CORNER D.L.C. NO. 84
FD. BRASS DISK IN MON. WELL

SURVEY NARRATIVE TO COMPLY WITH PARAGRAPH 209.250
 OREGON REVISED STATUTES

SURVEY FOR: Marquess & Marquess
 12 Goldy Building
 Medford, Oregon


LOCATION: Tract situated in Donation Land Claim No. 84, in
 Section 36, Township 37 South, Range 2 West,
 Willamette Meridian, Jackson County, Oregon.

PURPOSE: To locate, monument, and describe the property
 corners of the tract as shown on the map accompany-
 ing this narrative.

PROCEDURE: Located all corners marking the boundary of Donation
 Land Claim No. 84 and traversed between them to determine the center
 of said Donation Land Claim. An attempt was made to locate the initial
 point of the Wilson Park Subdivision, but did locate property pins along
 the west line of said Subdivision. The legal descriptions of tracts
 described in Jackson County Instrument Nos. 7311307 and 72-13973 were
 combined for the purpose of this survey. The corners of the tract
 were monumented with 5/8 inch iron pins as shown.

Basis of Bearings--Recorded Survey No. 496.

May 7, 1974

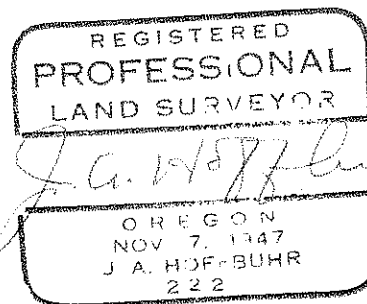

J. A. Hoffbuhr
 Professional Land Surveyor

