


5636

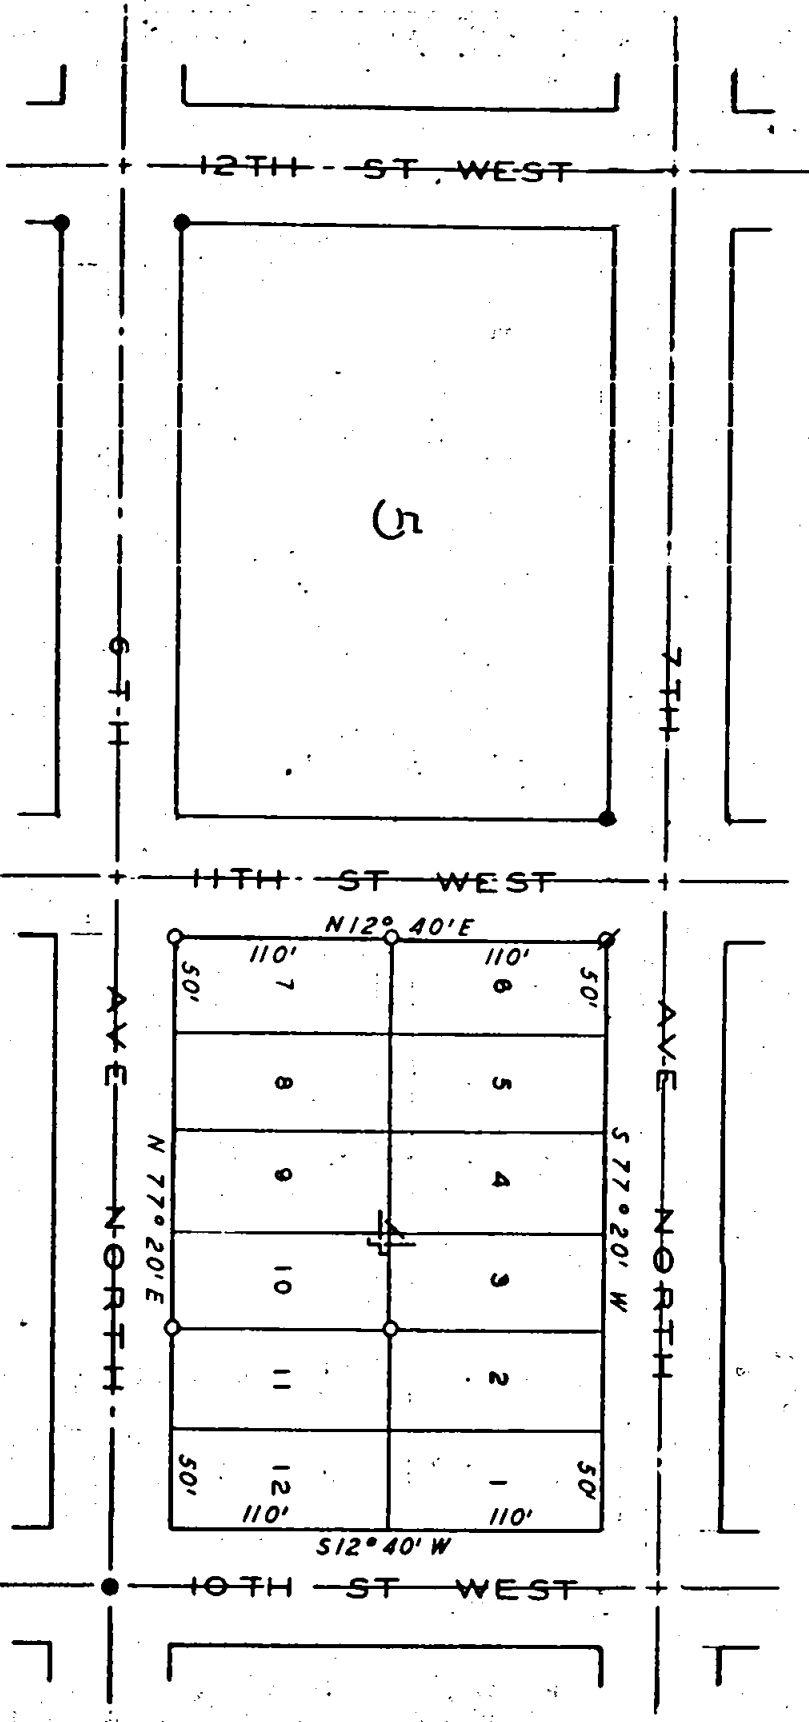


JACKSON COUNTY
RECEIVED
MAY 20 1974
SURVEYOR

REGISTERED
PROFESSIONAL
LAND SURVEYOR
G. W. Plumb
OREGON
JULY 12, 1968
G. W. PLUMB
862

BEARINGS FROM PLAT
● FOUND MONUMENT
○ SET 5/8" X 24" IRON ROD
△ SET 5/8" X 30" IRON ROD
SCALE 1" = 100'

PROPERTY SURVEY
SITUATE IN
DEKUMS AMENDED ADDITION
TO
GOLD HILL, OREGON
IN THE
SE 1/4 SEC 16 T 36 S R 3 W W/M
JACKSON COUNTY OREGON
G W PLUMB LAND SURVEYOR
MEDFORD OREGON 10 APRIL 1974

5636

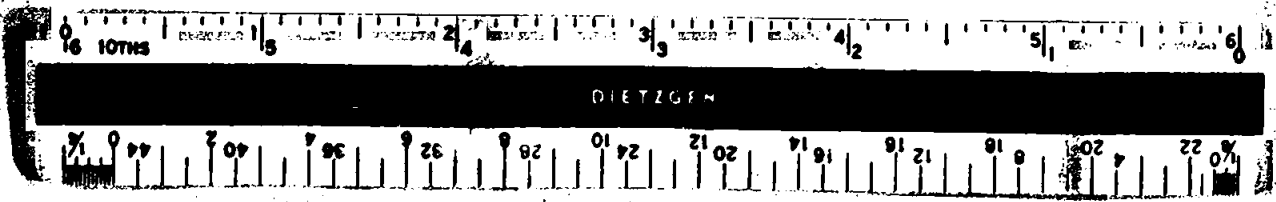

Survey for Richard P. Faltersack
275 Fourth Avenue
Gold Hill, Oregon 97525

Survey by G. W. Plumb Land Surveyor
P. O. Box 904
Medford, Oregon 97501

Location Block 4, Dekum's Amended Addition to Gold Hill, Oregon, in
the SE 1/4 Section 16, T. 36 S., R. 3 W., W. M., Jackson
County, Oregon.

Found monument at the center line intersection of 6th Avenue North and 10th
Street West. Found lot corner monuments on both sides of 6th Avenue North
at 12th Street West. Found monument at the NE corner of Block 5. Using this
control, set 5/8 inch x 30 inch iron rod at the Northwest corner of Block
4, and 5/8 inch iron rods 24 inches long at the NW and SW corners of Lot
7, and at the NE and SE corners of Lot 10, of Block 4, of Dekum's Amended
Addition.

23 April 1974

REGISTERED
PROFESSIONAL
LAND SURVEYOR

OREGON
JULY 12, 1968
G. W. PLUMB
862

JACKSON COUNTY
RECEIVED
MAY 20 1974
SURVEYOR

S16DD /
S16 T36S R3W