

5646

Ook St.

3RD STREET

30.0'

181.50'

S 22° 34' 20" W

100.0'

6.900'

30.0'

50.0'

0.0'

202.00

30.0'

97.00'

BLK 59

2

S 86° 31' 25" E

102.85'

N 22° 34' 20" E 79.10'

110.91'

100.00'

N 81° 02' 41" W

104.61'

107.84'

207.84'

90.0'

100.0'


S 22° 34' 20" W

4TH STREET

LEWIS ST

Fd.

30.0'

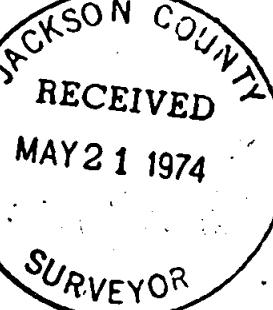

SURVEY IN NW. 1/4 SEC. 32, T. 37S., R. 2 W., W.M.
CITY OF JACKSONVILLE

FOR

CLYDE MOAK
74-6

BY EDWARD MC GINTY
MEDFORD OREGON
MARCH 1974

SCALE 1" = 50

0 = 5/8" I. PIN

② = 3/4" I. PIN FD.


REGISTERED
PROFESSIONAL
LAND SURVEYOR

Edward U. Mc Ginty

OREGON
JULY 10, 1963
EDWARD A. MC GINTY
SOI

5646

-5846

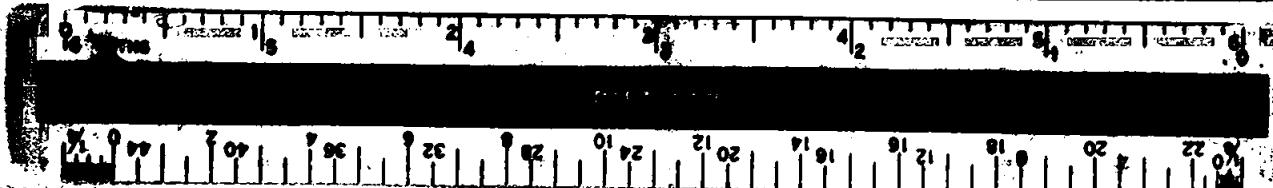

5646

SURVEY NO. 3836

SURVEY NARRATIVE TO COMPLY WITH O.R.S. 209-250

SURVEY FOR: Clyde Moak 74-6
P.O. Box 324
Jacksonville, Oregon 97530

SURVEY BY: Edward A. McGinty, R.S.
Medford, Oregon
April, 1974

LOCATION: NW 1/4 Sec. 32, T37S, R2W, WM
Blk 59, City of Jacksonville

RASIS OF BEARING: Survey No. 4582


PRECEDENCE OF SURVEY:

The northerly line of the survey was previously determined on Survey No. 4582 and the extension thereof. The easterly portion being along the existing improvements. The westerly and southerly line were determined from deed records Vol. 509, page 517.

Monuments set being 5/8" x 24" iron pins.

At intersection of 4th & Oak St. found 3/4" iron pin, 12" deep.

At intersection of 4th & Lewis St. found 3/4" iron pin, 6" deep.

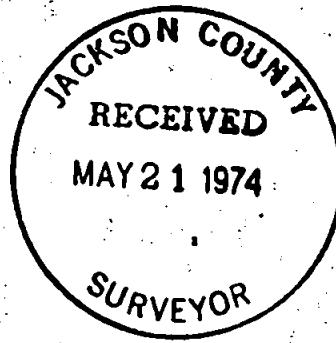

32 BC

S32 T37S R2W