

# MEDFORD SHOPPING CENTER, INC.

SURVEY FOR:  
 LOCATED IN THE SW 1/4 OF  
 SEC. 8, T. 37S. R. 1W., W.M. MEDFORD, OREGON  
 BY: MARK E. BOYDEN  
 MAY 17, 1974

REGISTERED  
**PROFESSIONAL**  
 LAND SURVEYOR  
*Mark E. Boyden*  
 OREGON  
 NOV. 9, 1951  
 MARK E. BOYDEN  
 281

JACKSON C. ...  
 RECEIVED  
 MAY 23 1974  
 SURVEYOR

SCALE 1"=100'  
 BASIS OF BEARINGS  
 RECORDED SURVEY NO. 8025  
 ○ FD. MONUMENT AS INDICATED  
 ● SET 3/4" x 2 1/2" I. PIN FL. UNLESS  
 OTHERWISE INDICATED



SURVEY NARRATIVE TO COMPLY WITH O.R.S. 209.250

FOR: Medford Shopping Center, Inc.  
751 Medford Shopping Center  
Medford, Oregon, 97501

PURPOSE: To monument and describe a tract proposed to be segregated  
from the Tom Cardona ownership in the SW 1/4 of Section 8,  
T37SR1W, W.M.

PROCEDURE: From monuments found set on Recorded Survey No. 5025,  
monumented the corners of the desired tract as shown on  
the annexed map.

May 17, 1974

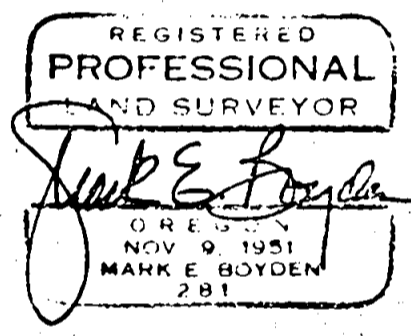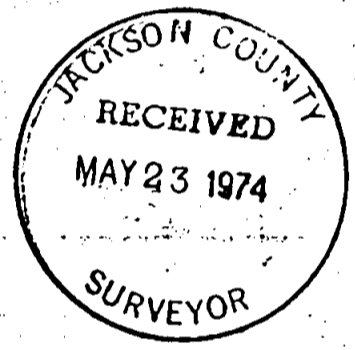

S8 T37S R1W