

BOUNDARY LINE
 AGREEMENT PER INSTRUMENT
 No. 68-06801-1/2

MAP OF SURVEY
 LOCATED IN
 S.W. 1/4 OF SEC. 30, TWP. 39 S., R. 2 E., W.M.
 JACKSON COUNTY OREGON
 FOR


KARL WINDBIGLER

EVERETT L. SWAIN, R.L.S. ASHLAND, OREGON

SCALE: 1" = 200'
 BASIS OF BEARING:

MARCH 20, 1971
 RECORDED SURVEY NO. 3772

- FOUND MONUMENTS AS SHOWN
- SET MONUMENTS AS SHOWN

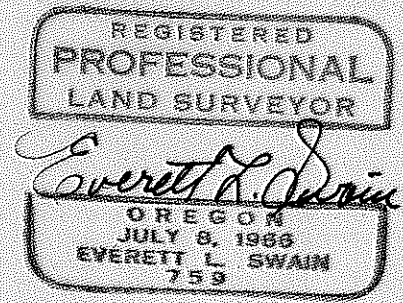

SURVEY NARRATIVE TO COMPLY WITH PARAGRAPH 209.250
OREGON REVISED STATUTES

SURVEY FOR: Karl Windbigler
P. O. Box 858
Ashland, Oregon 97520

LOCATION: Situated in the Southwest quarter of Section 30, Township 39
South, Range 2 East of the Willamette Base and Meridian, Jackson
County, Oregon.

PURPOSE: To monument those tracts of land per legal descriptions prepared
for my client at his request, in mid 1970.

PROCEDURE: Utilizing recorded survey no. 3772 and 4270 proceeded to survey
those tracts as shown on the accompanying map.

Everett L. Swain
Professional Land Surveyor
Ashland, Oregon

