


SCALE: 1" = 300'

NOTE:

- = MON. FD.
- = 5/8" X 30" I ROD SET
- ALL BEARINGS ARE BASED ON PREVIOUS SURVEY FOR CARL ANDERSON, NO. 5283

SURVEY
 IN
 SE 1/4 OF SEC 15 T.36 S., R.4 W., W.M.,
 JACKSON COUNTY, OREGON
 FOR
 RAY HOPPER
 8941 ROGUE RIVER HWY.
 ROGUE RIVER, OREGON

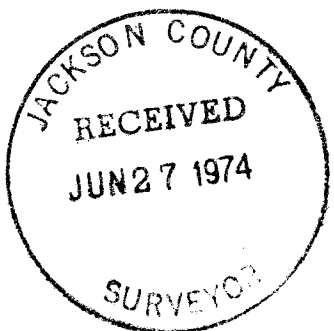

PER E ZIMMERLUND
 CONSULTING ENGINEER
 ROGUE RIVER OREGON
 W.O. 307 JUNE 6, 1974

5690

SURVEY NARRATIVE TO COMPLY WITH PARAGRAPH 209.250 O. R. S.

SURVEY FOR: Ray Hopper
8941 Rogue River Highway
Grants Pass, Oregon


LOCATION: In the Southeast Quarter of Section 15, Township 36
South, Range 4 West, Willamette Meridian, Jackson County,
Oregon.

PURPOSE: To survey and monument that parcel described in instru-
ment No. 74-05953 of the Jackson County Deed Records.

PROCEDURE: In order to define the East line of Lot 16 of Meadowbrook
Orchard Company's Subdivision, it was necessary to sub-
divide the SE $\frac{1}{4}$ of said Section 15. Using data from previ-
ous survey for Carl Anderson and traversing into the
Southeast Corner of said Section 15 the proportionate
distances of the lots within the SE $\frac{1}{4}$ of Section 15 were
calculated. I then set pins as shown on the attached
plat per instrument No. 74-05953 of the Jackson County
Deed Records.

All bearings are based on previous Survey No. 5283.

Survey was executed with a Wild T-16ED Transit
Theodolite and 200.00 foot steel chain.

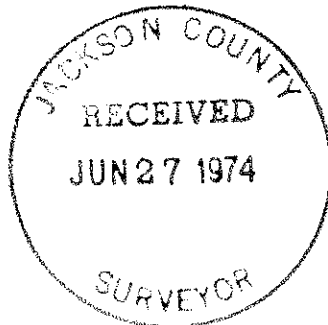

June 6, 1974