

SURVEY PLAT & NARRATIVE TO COMPLY WITH
PARAGRAPH 209.250, OREGON REVISED STATUTES


Survey for: Virginia W. Cotton
1120 Prospect Avenue
Ashland, Oregon 97520

Survey by : Charles H. Hurst, L.S.
23 North Ivy
Medford, Oregon 97501

Purpose : To revise a portion of the division line shown by Recorded
Survey No. 5249 to exclude certain topographical features
adjacent to said line.

Bearing : By solar observation taken at a previous date.

SURVEY SITUATE IN THE E½ NE¼ SE¼ NE¼ SECTION 16,
T. 39 S., R. 1 E., W.M., JACKSON COUNTY, OREGON.

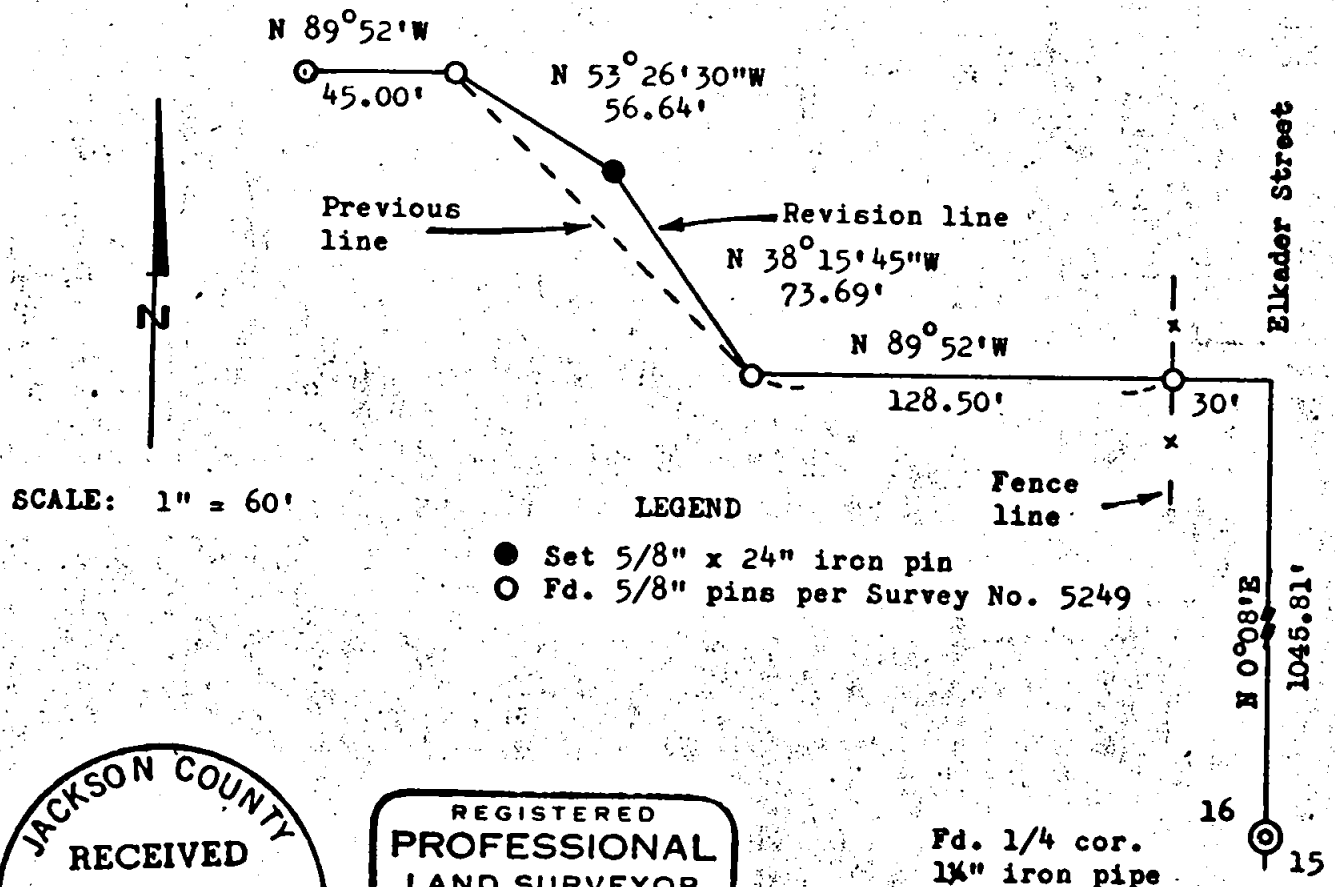

JACKSON COUNTY
RECEIVED
AUG 23 1974
SURVEYOR

REGISTERED
PROFESSIONAL
LAND SURVEYOR

Charles H. Hurst

OREGON
OCTOBER 30, 1959
CHARLES H. HURST
483

APR 15 1974

