

SURVEY NARRATIVE AND PLAT TO COMPLY WITH  
PARAGRAPH 209.250, OREGON REVISED STATUTES

Survey for: Mrs. Dorothy Uriarte  
2184 Crestbrook Road  
Medford, Oregon 97501

Survey by: Charles H. Hurst, L.S.  
23 North Ivy  
Medford, Oregon 97501



Meridian: Based on deed record

Purpose: To monument the corners of tract described in Instrument  
No. 74-03212 of Official Records, Jackson County, Oregon.

Procedure:

Raised the centerline of Crestbrook Road and set the corners of said tract therefrom.

SURVEY SITUATE IN DONATION LAND CLAIM 51  
SE1/4SW1/4 Section 29, T. 37 S., R. 1 W., W.M.  
Medford, Oregon

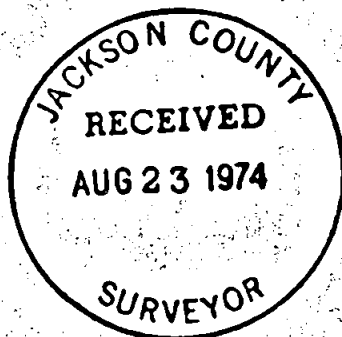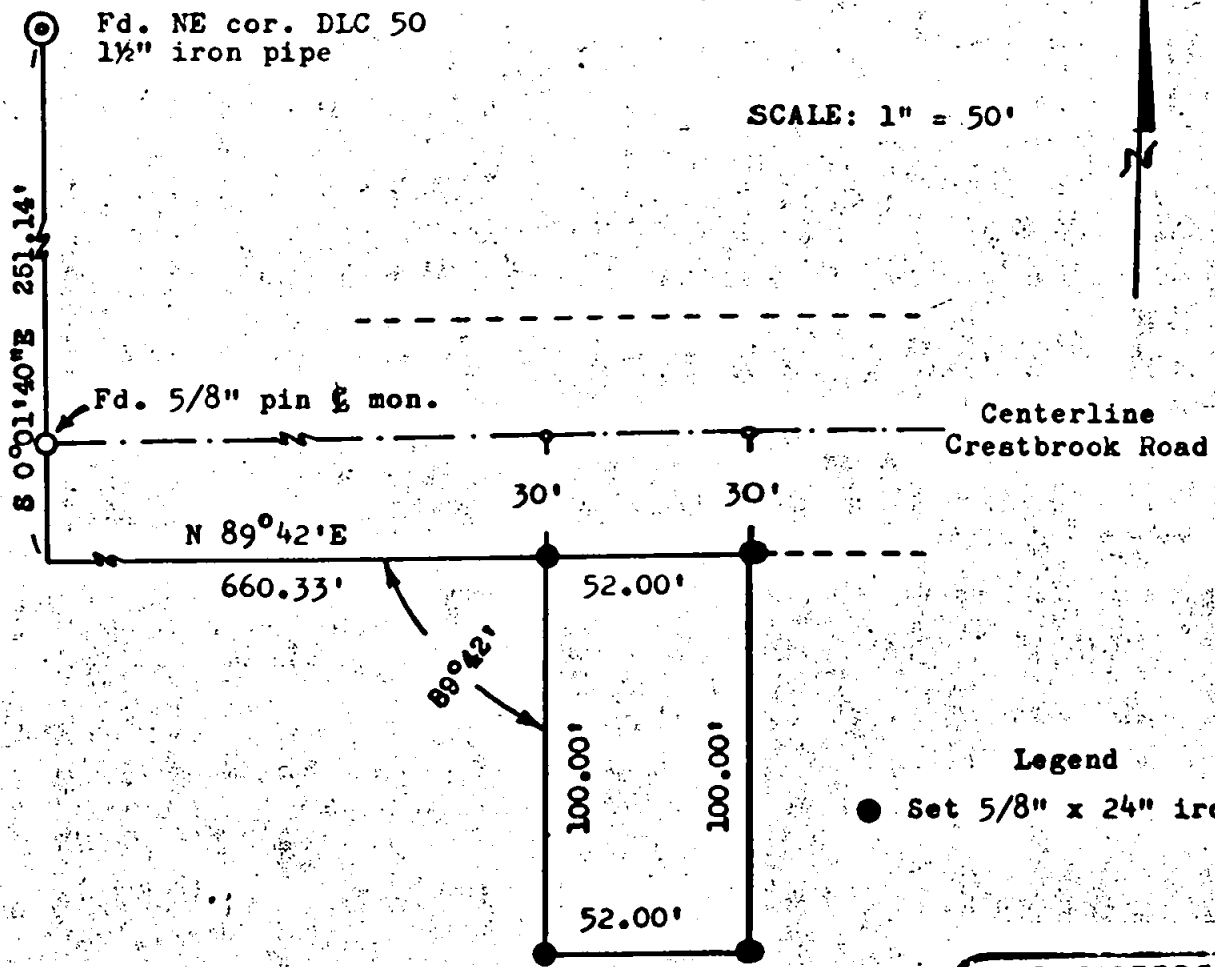

REGISTERED  
PROFESSIONAL  
LAND SURVEYOR

*Charles H. Hurst*

OREGON  
OCTOBER 30, 1959  
CHARLES H. HURST  
483

APR 19 1974