

SURVEY PLAT & NARRATIVE TO COMPLY WITH
PARAGRAPH 209.250, OREGON REVISED STATUTES

Survey for: Emerson Hofsommer
11661 Odessa Avenue
Granada Hills, Calif.
91334


Survey by: Charles H. Hurst, L.S.
23 North Ivy St.
Medford, Oregon 97501

Purpose : To monument the corners of tract described in Instrument
No. 73-00588 of Official Records, Jackson County, Oregon.


Bearing : Based on the meridian for Survey No. 291.

Procedure : Distances by EDM equipment.

Survey situate in the NW 1/4 & Gov't. Lot 2, Section 16,
T. 34 S., R. 1 W., W.M.
Jackson County, Oregon.

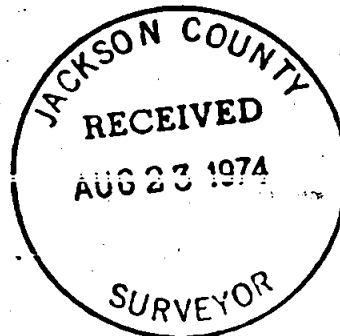

SCALE: 1" = 100'

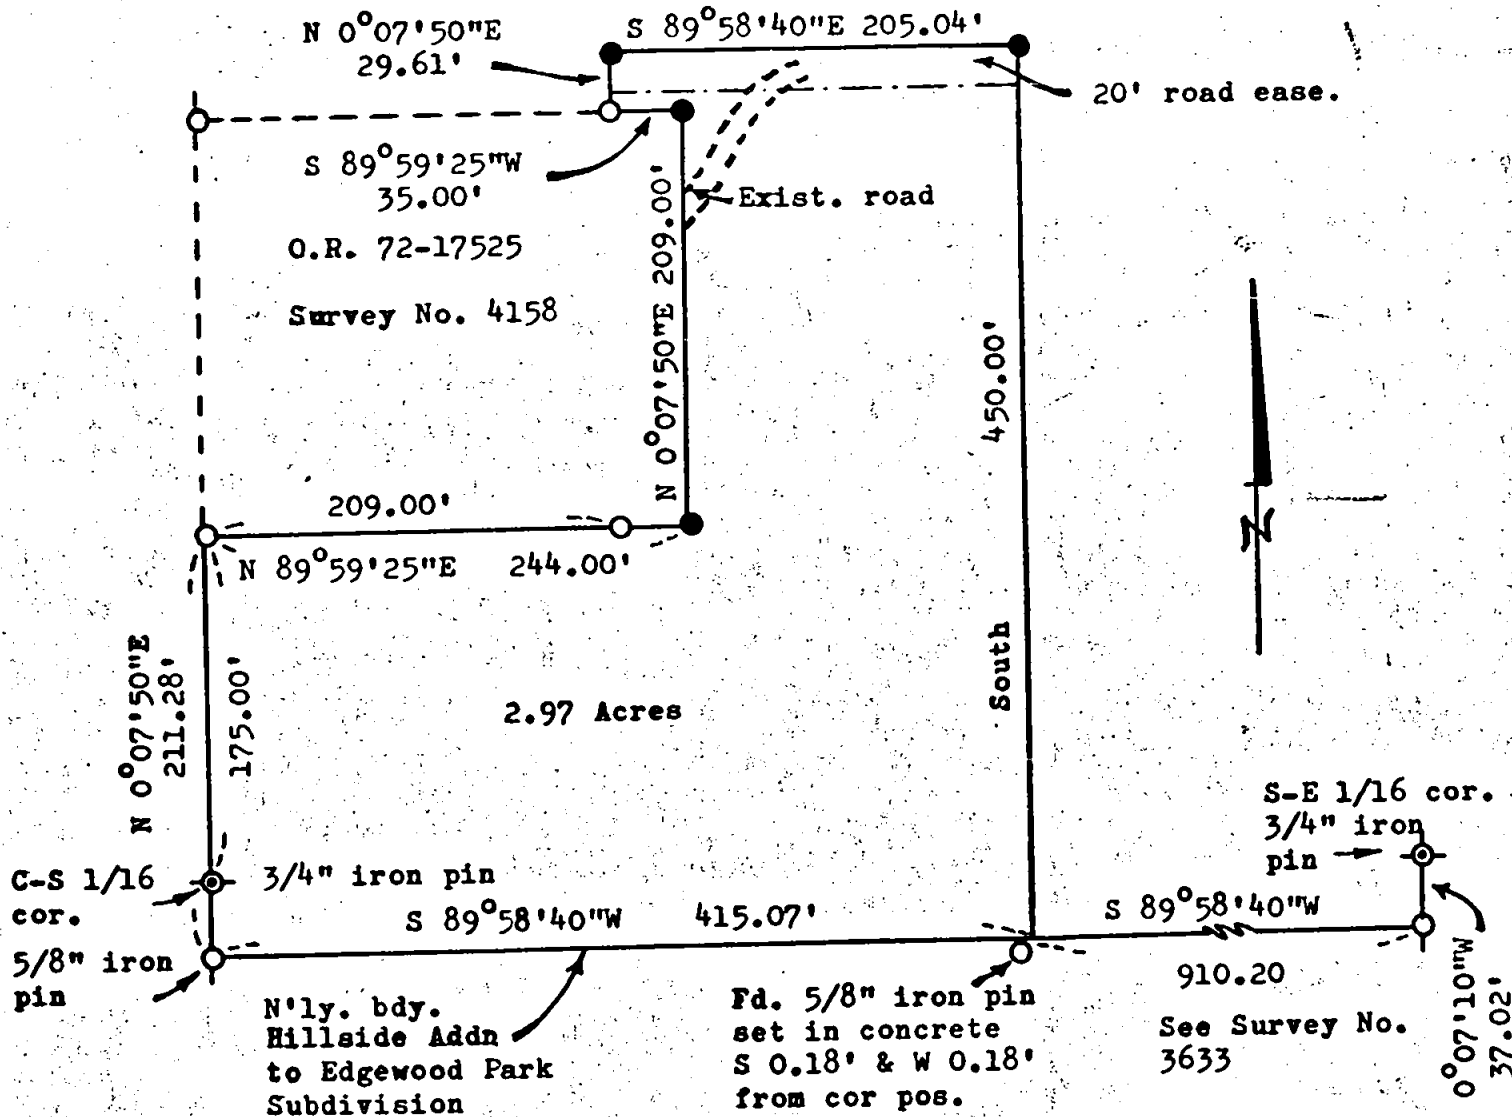

LEGEND

- Set 5/8" x 24" iron pins
- Found 5/8" iron pins

REGISTERED
PROFESSIONAL
LAND SURVEYOR

Charles H. Hurst

OREGON
OCTOBER 30, 1959
CHARLES H. HURST
483

MAY 13 1974