

SURVEY


NE 1/4 OF SECTION 17 T.35S. R.4W. WM.,
 JACKSON COUNTY, OREGON

FOR
 MR. D.S. RASMUSSEN
 1835 QUEENS BRANCH RD.
 ROGUE RIVER, OREGON


SCALE: 1" = 300'

• MON PD
 • 5/8" x 30" I 200 SET
 ALL BEARINGS PER SOLAR
 OBSERVATION

TL III

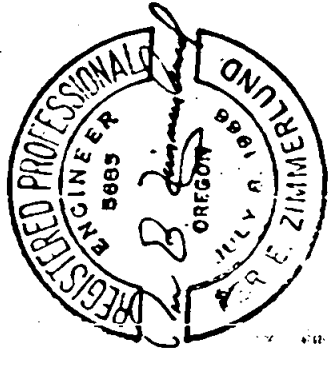

PER E. ZIMMERLUND
 CONSULTING ENGINEER
 ROGUE RIVER, OREGON
 WO # 316 SEPT. 1974

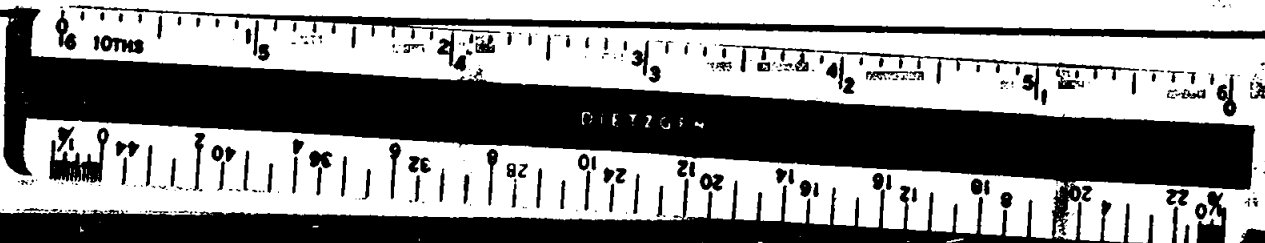

SURVEY NARRATIVE TO COMPLY WITH PARAGRAPH 209.250 O. R. S.

5812

SURVEY FOR: D. S. Rasmussen
1835 Queens Branch Road
Rogue River, Oregon 97537

LOCATION: NE $\frac{1}{4}$ of Section 17, Township 35 South, Range 4 West,
Willamette Meridian, Jackson County, Oregon.

PURPOSE: To survey and monument the North line of Tax Lot 111.

PROCEDURE: Beginning at the Section Corner common to Sections 8,
9, 16 and 17 monumented by a county surveyed brass cap;
I sight the North $\frac{1}{4}$ Corner of Section 17; thence I run
S 89°54'38" W along the North line of Section 17
1329.897 feet single proportionate measurement, to the
E 1/16 Corner, monumented by a 5/8" x 30" iron rod;
from which:



a 20" diameter black oak which bears N 29° E 69.20
feet distance, marked E 1/16 R.E. 5685 BT

a 7" diameter yellow pine which bears S 41° E 32.75
feet distance, marked E 1/16 R.E. 5685 BT

thence I run N 89°54'38" E along said North line
302.47 feet at which point I set a 5/8" x 30" diameter
iron rod; thence I continue N 89°54'38" E along said
North line 30.00 feet at which point I set a 5/8" x 30"
diameter iron rod.

Bearings based on solar observation and referred to
true meridian.

Survey was executed with a Wild T-16ED Transit Theodolite
and 200.00 foot steel chain.

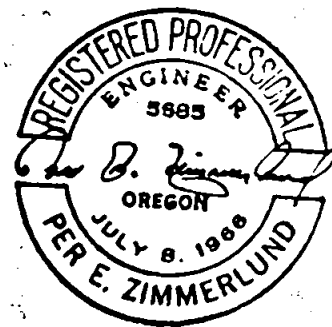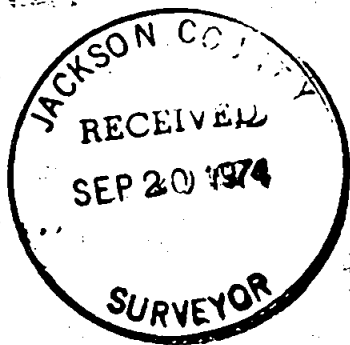

September, 1974