

MAP OF SURVEY
 LOCATED IN
 NW 1/4 OF SEC. 8, T. 39S., R. 1W.W.M.
 JACKSON COUNTY OREGON
 FOR



GRANT RICHEY

EVERETT L. SWAIN, R.L.S. ASHLAND, OREGON
 SCALE: 1"=100' SEPTEMBER 17, 1974
 BASIS OF BEARING: SOLAR OBSERVATION

- FOUND MONUMENTS AS SHOWN
- SET 5/8 x 24 INCH IRON PIN TAGGED RLS 759 UNLESS OTHERWISE SHOWN

REGISTERED
 PROFESSIONAL
 LAND SURVEYOR
Everett L. Swain
 OREGON
 JULY 8, 1966
 EVERETT L. SWAIN
 759

- from which
- A RED FIR, 7" DIA., BRS. S. 82° 38' E., 25.6' SCRIBED W 1/16 S 8 BT
 - A RED FIR, 10 1/2" DIA., BRS. S. 52° 13' W., 19.55' SCRIBED W 1/16 S 8 BT

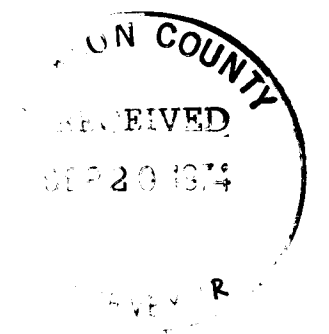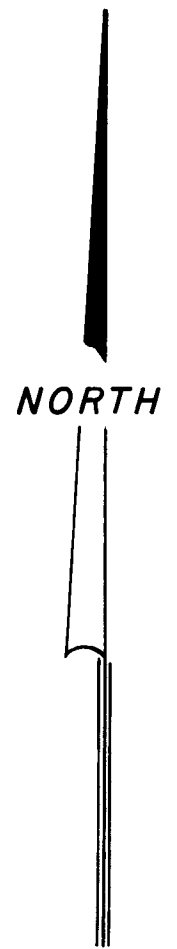

SURVEY NO. _____

SURVEY NARRATIVE TO COMPLY WITH PARAGRAPH 209.250
OREGON REVISED STATUTES

SURVEY FOR: Grant Richey
4832 Anderson Creek Road
Talent, Oregon 97540

LOCATION: Situated in the Northwest quarter of the Northwest quarter of Section 8, Township 39 South, Range 1 West of the Willamette Meridian, Jackson County, Oregon.

PURPOSE: To survey and monument the North boundary of the Northwest quarter of the Northwest quarter of Section 8, Township 39 South, Range 1 West of the Willamette Meridian, Jackson County, Oregon per clients request.

PROCEDURE: A Wild T-2 theodolite, Hewlett-Packard 3800A distance meter and a 200 foot chrome clad 1/4 inch wide steel tape with tension handles and tape theometer were used to conduct this survey. A random closed traverse was established with side ties to the section corner and quarter corner. All angles and measurements which were not included in the closed traverse were observed twice (2). The average of the 2 observed values was used in establishing the final section line location.

The existing fence bearing Westerly from Anderson Creek Road does not appear to have been established upon any survey line. The new barb wire is strung from tree to tree, sometimes running in an arc and some very distant angle points also appear.

A well blazed and brushed line is in evidence East of Anderson Creek Road. A 3/4 inch iron pipe was found driven in the top of a cedar stump. Beyond this point there ceased to be any evidence of a brushed survey line or blazed trees. This pipe may have been stubbed in from the section corner. However, there is no proof positive as to how this pipe was set or who set it.

September 17, 1974

Everett L. Swain
Professional Land Surveyor
Ashland, Oregon

