

S.E. Cor. D.L.C. No. 38
 Twp. 36 S, R 3 W W.M.
 Fd. 1 1/2" G.I. Pipe




SCALE 1" = 50'

Basis of Bearing R.S. No. 4483

- = Set 5/8" I. Pin tagged R.L.S. 638
- = Fd. 5/8" I. Pin tagged R.L.S. 638 (unless noted otherwise)

REGISTERED
 PROFESSIONAL
 LAND SURVEYOR
George Burrell
 OREGON
 JULY 10, 1964
 GEORGE R. BURRELL
 638

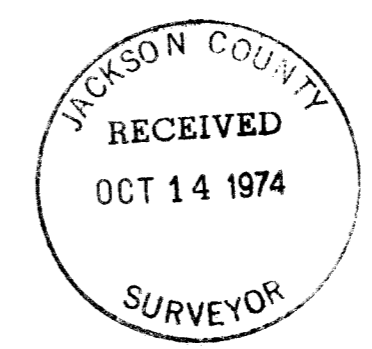

MAP OF SURVEY

Located in Section 26, Twp 36 S, R 3 W W.M.
 For: RICHARD WELTER, GRANTS PASS, OR.
 By: George Burrell, Surveyor, Oct. 1974

SURVEY NARRATIVE TO COMPLY WITH O.R.S. 209.250
REVISED BY CHAPTER 555, O.L. 1963

FOR: Richard Welter
7001 Rogue River Hwy. Space #43
Grants Pass, Oregon 97526

PURPOSE: To monument the Northwesterly boundary of the tract described
in Document No. 68-10651 of the Official Records of Jackson
County.

PROCEDURE: The monuments of Recorded Survey No. 4483 were recovered and
used as control in establishing said boundary according to
deed record.

