



Initial Point
 COUNTRY CLUB PARK SUBD.
 Fd. 2" O.D. 1. Pipe 6" deep

Basis of Bearings: Plot Record
 O = Set 5/8" I. Pin tagged R.L.S638

SCALE 1"=50'

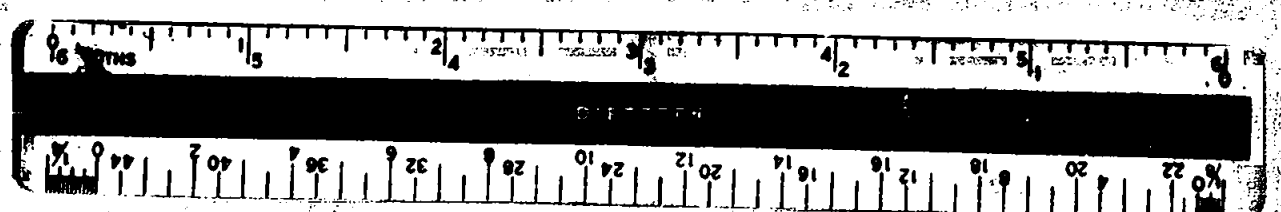

SE. COR.
 COUNTRY CLUB PARK SUBD.
 Fd. 5/8" I. Pin
 Re: R.S. No. 683

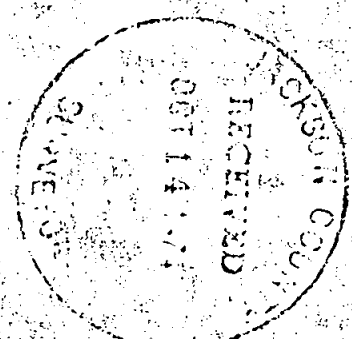

MAP OF SURVEY

Located in lot 25 COUNTRY CLUB
 PARK SUBD. in Sec. 29, Twp. 37S, R1W
 For: PAUL MEYERS, MEDFORD, ORE.
 By: George Burrell, Surveyor Oct. 1974

REGISTERED
 PROFESSIONAL
 LAND SURVEYOR
George Burrell
 OREGON
 JULY 10, 1964
 GEORGE R. BURRELL
 R.S.P.

SURVEY NARRATIVE TO COMPLY WITH O.R.S. 209.250
REVISED BY CHAPTER 555, O.L. 1963

FOR: Paul Meyers
181 Black Oak Dr.
Medford, Oregon

PURPOSE: To monument the North boundary of lot 25 of COUNTRY CLUB PARK SUB.

PROCEDURE: The Initial Point and the Southeast corner of said Subdivision was recovered from which the Northeast corner of lot 25 was established according to the proportional distance as shown on the accompanying map. The Northwest corner of lot 25 was then established according to plat record angle and distance from the Northeast corner in lieu of any monuments or previous surveys indicating otherwise.

REGISTERED
PROFESSIONAL
LAND SURVEYOR

George R. Burrell

OREGON
JULY 10, 1964
GEORGE R. BURRELL
638

JACKSON COUNTY
RECEIVED
OCT 14 1974
SURVEYOR