


SURVEY FOR DAVID JENKINS

Located in the NE 1/4, Sec. 30, T37SR2W, W.M.


By: MARK E. BOYDEN

Oct. 15, 1974


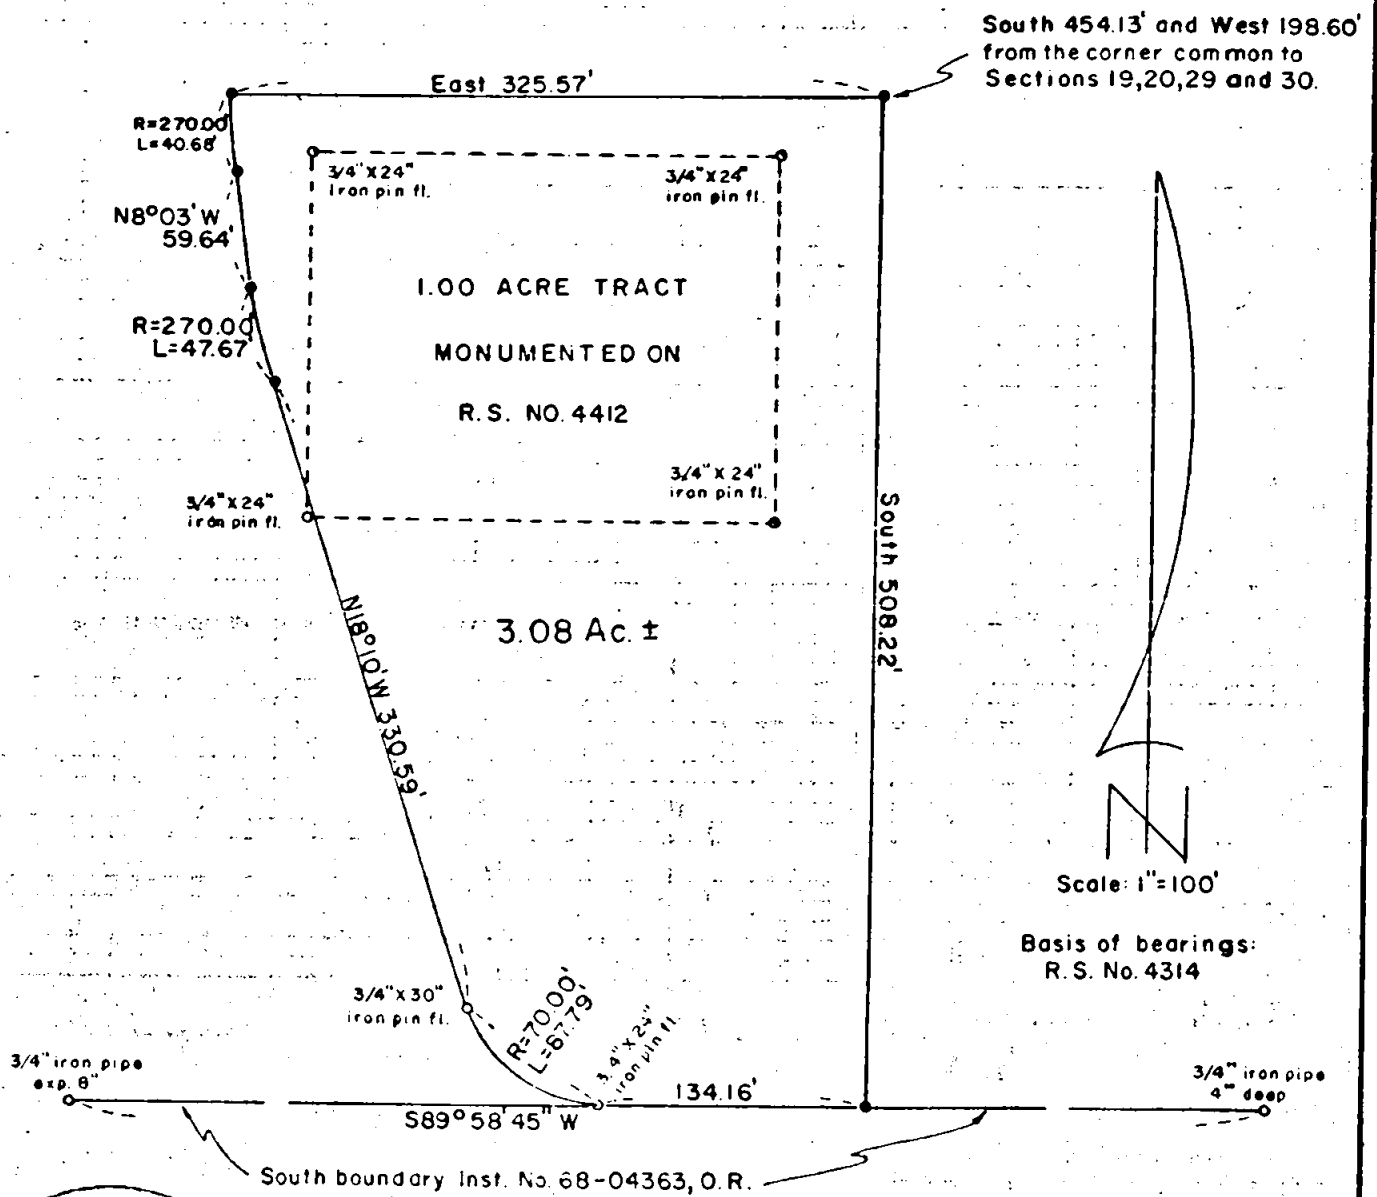


Scale: 1"=100'

Basis of bearings:
R.S. No. 4314

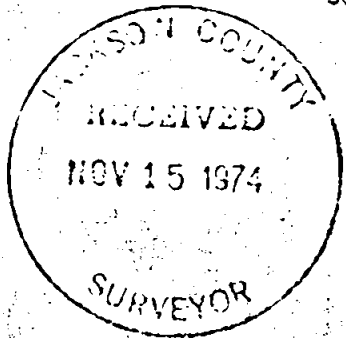

- Found monument as indicated
- Set 3/4" x 24" iron pin flush

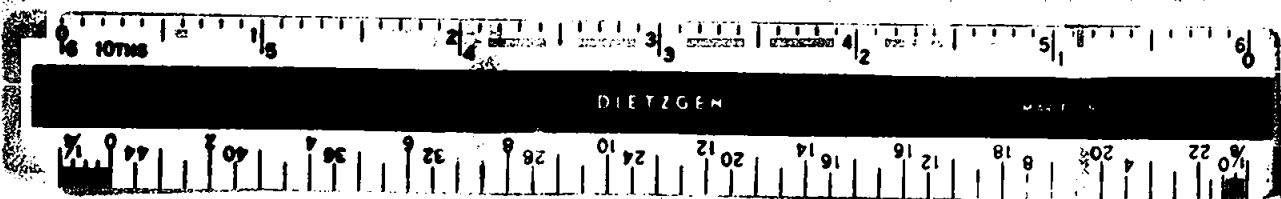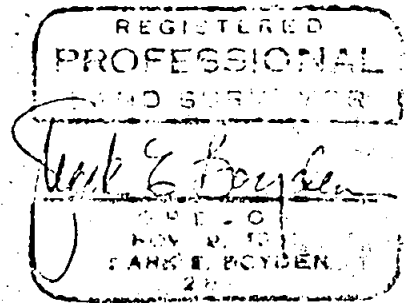

SURVEY NARRATIVE TO COMPLY WITH O.R.S. 209.250.

FOR: David Jenkins
4106 Livingston Road
Medford, Oregon, 97501

PURPOSE: To monument and describe the consolidated ownership of Jenkins after having acquired tracts from Ray Offord, Jr. and Stuart V. Hinson, in Section 30, T37SR2W, W.M.

PROCEDURE: From monuments found as previously set on Recorded Survey No. 4412, monumented the new boundaries as shown on the annexed map.

October 15, 1974

