
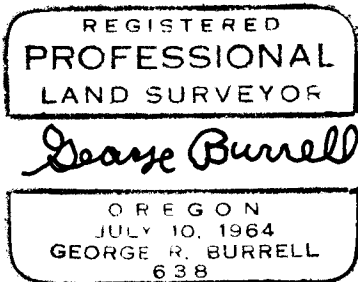


SCALE 1"=200'

Basis of Bearings: N.G.S.  
True from sta. "Woods"  
corr. 0°00'48"C.C.W.

**LEGEND**

- = Set 5/8" x 30" I. Pin tagged R.L.S 638
- = Fd. 5/8" Copper rod in conc. mon.
- ⊙ = Fd. monument as noted

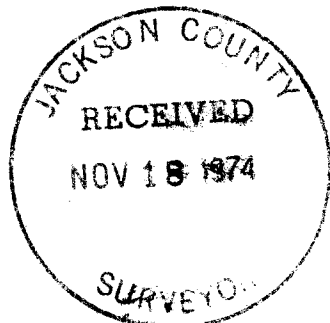

**MAP OF SURVEY**

Located in S.W. 1/4 Sec. 15, T37S, R1W  
For: T. J. GUETZLAFF, MEDFORD, ORE.  
By: Geo. Burrell, Surveyor Oct. 1974  
Survey commenced Oct. 1973

SURVEY NARRATIVE TO  
COMPLY WITH O.R.S.  
209.250 REV. BY CH.  
555, O.L. 1963

FOR: Ted Guetzlaff  
4195 Rachel Way  
Medford, Oregon

PURPOSE: To monument the outside boundaries of the Guetzlaff property in the SW1/4 of Sec. 15 and to remonument the boundaries of the Bolton property. To monument and describe that portion of the Guetzlaff property being conveyed to Bolton ( the 245.00 by 192.33 foot parcel as shown on the accompanying map ).

PROCEDURE: The original remonumented Government corners controlling the boundaries of the SW1/4 were recovered (excepting the S 1/4 corner of Sec. 15 ). The monument found at said 1/4 corner was in agreement with the proportional position as established by Recorded Survey No. 709, and therefore was held as control in the absence of evidence of the Original Bearing Tree's. Said controlling Section corners were traversed to by E.D.M. equipment utilizing a 20" optical theodolite. From the coordinate positions thus obtained the outer boundaries were calculated and monumented according to Deed Record. The Bolton property remonumented by this survey, was established at right angles to the section line at record distance, which was found in agreement with hubs found that were set by Surveyor L.E. Ager for the original survey of the Bolton tract ( Survey unrecorded ).

REGISTERED  
PROFESSIONAL  
LAND SURVEYOR

*George Burrell*

OREGON  
JULY 10, 1964  
GEORGE R. BURRELL  
638

