

N 1/2 & N 1/2 N 1/2 S 1/2 NE 1/4 SE 1/4
PETER MOSCH

11 12 1/4 Cor Sec's 11 & 12 T39 SRIW
Fd. 1" I. Pipe w/br. disc per C.S. 1967



SCALE 1"=100'

Basis of Bearings
Solar Observation

Wit. Cor.

Boundary line Agreement

S 1/2 S 1/2 & S 1/2 N 1/2 S 1/2 NE 1/4 SE 1/4
WILLIAM DICKSON

S 3° 44' 38" W
744.86


S 0° 06' 18" E
350.43
P. MOSCH

WAGNER CR.
W. DICKSON
CO. ROAD

REGISTERED
PROFESSIONAL
LAND SURVEYOR

George Burrell

OREGON
JULY 10 1954
GEORGE R. BURRELL

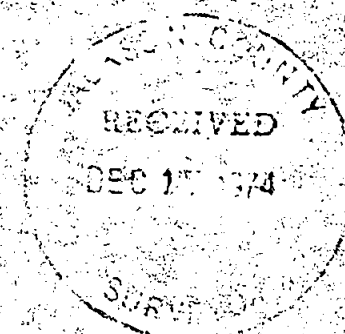

LEGEND

○ = Set 5/8" x 30" I. Pin (tagged R.L.S638)

--- = Lines not established by this survey

MAP OF SURVEY

Located in NE₄ SE₄ Sec. 11 T39 SRIW W.M.
For : PETER MOSCH, MEDFORD, ORE.
By : Geo. Burrell, Surveyor, Nov. 1974

SURVEY NARRATIVE TO COMPLY WITH O.R.S. 209.250

FOR: Peter Mosch
5723 S. Pacific Hwy.
Medford, Oregon

PURPOSE: To monument and describe a boundary line agreement between Peter Mosch and William Dickson establishing the boundary of said parties North of Wagner Creek Road.

PROCEEDURE: The Meridian was obtained from six observations of the Sun utilizing a 20" Franke Theodilite. Distances were measured with a H.P. 3805 distance meter. The 1/4 section corner was traversed to as was a found 2" dia. iron pipe which bears South 0° 06' 18" East 1303.83 feet from said 1/4 cor. The boundary line agreement was then established 50.00 feet Westerly at right angles to the line joining the monuments described above as this was the intent of said parties.

REGISTERED
PROFESSIONAL
LAND SURVEYOR

George Burrell

OREGON
JULY 10, 1964
GEORGE R. BURRELL
638

