


Survey For

BOB GAULT

Located in D.L.C. No. 68,
NE 1/4 Sec. 26, T.38S., R.1W., W.M.

By: Mark E. Boyden

Nov. 25, 1974



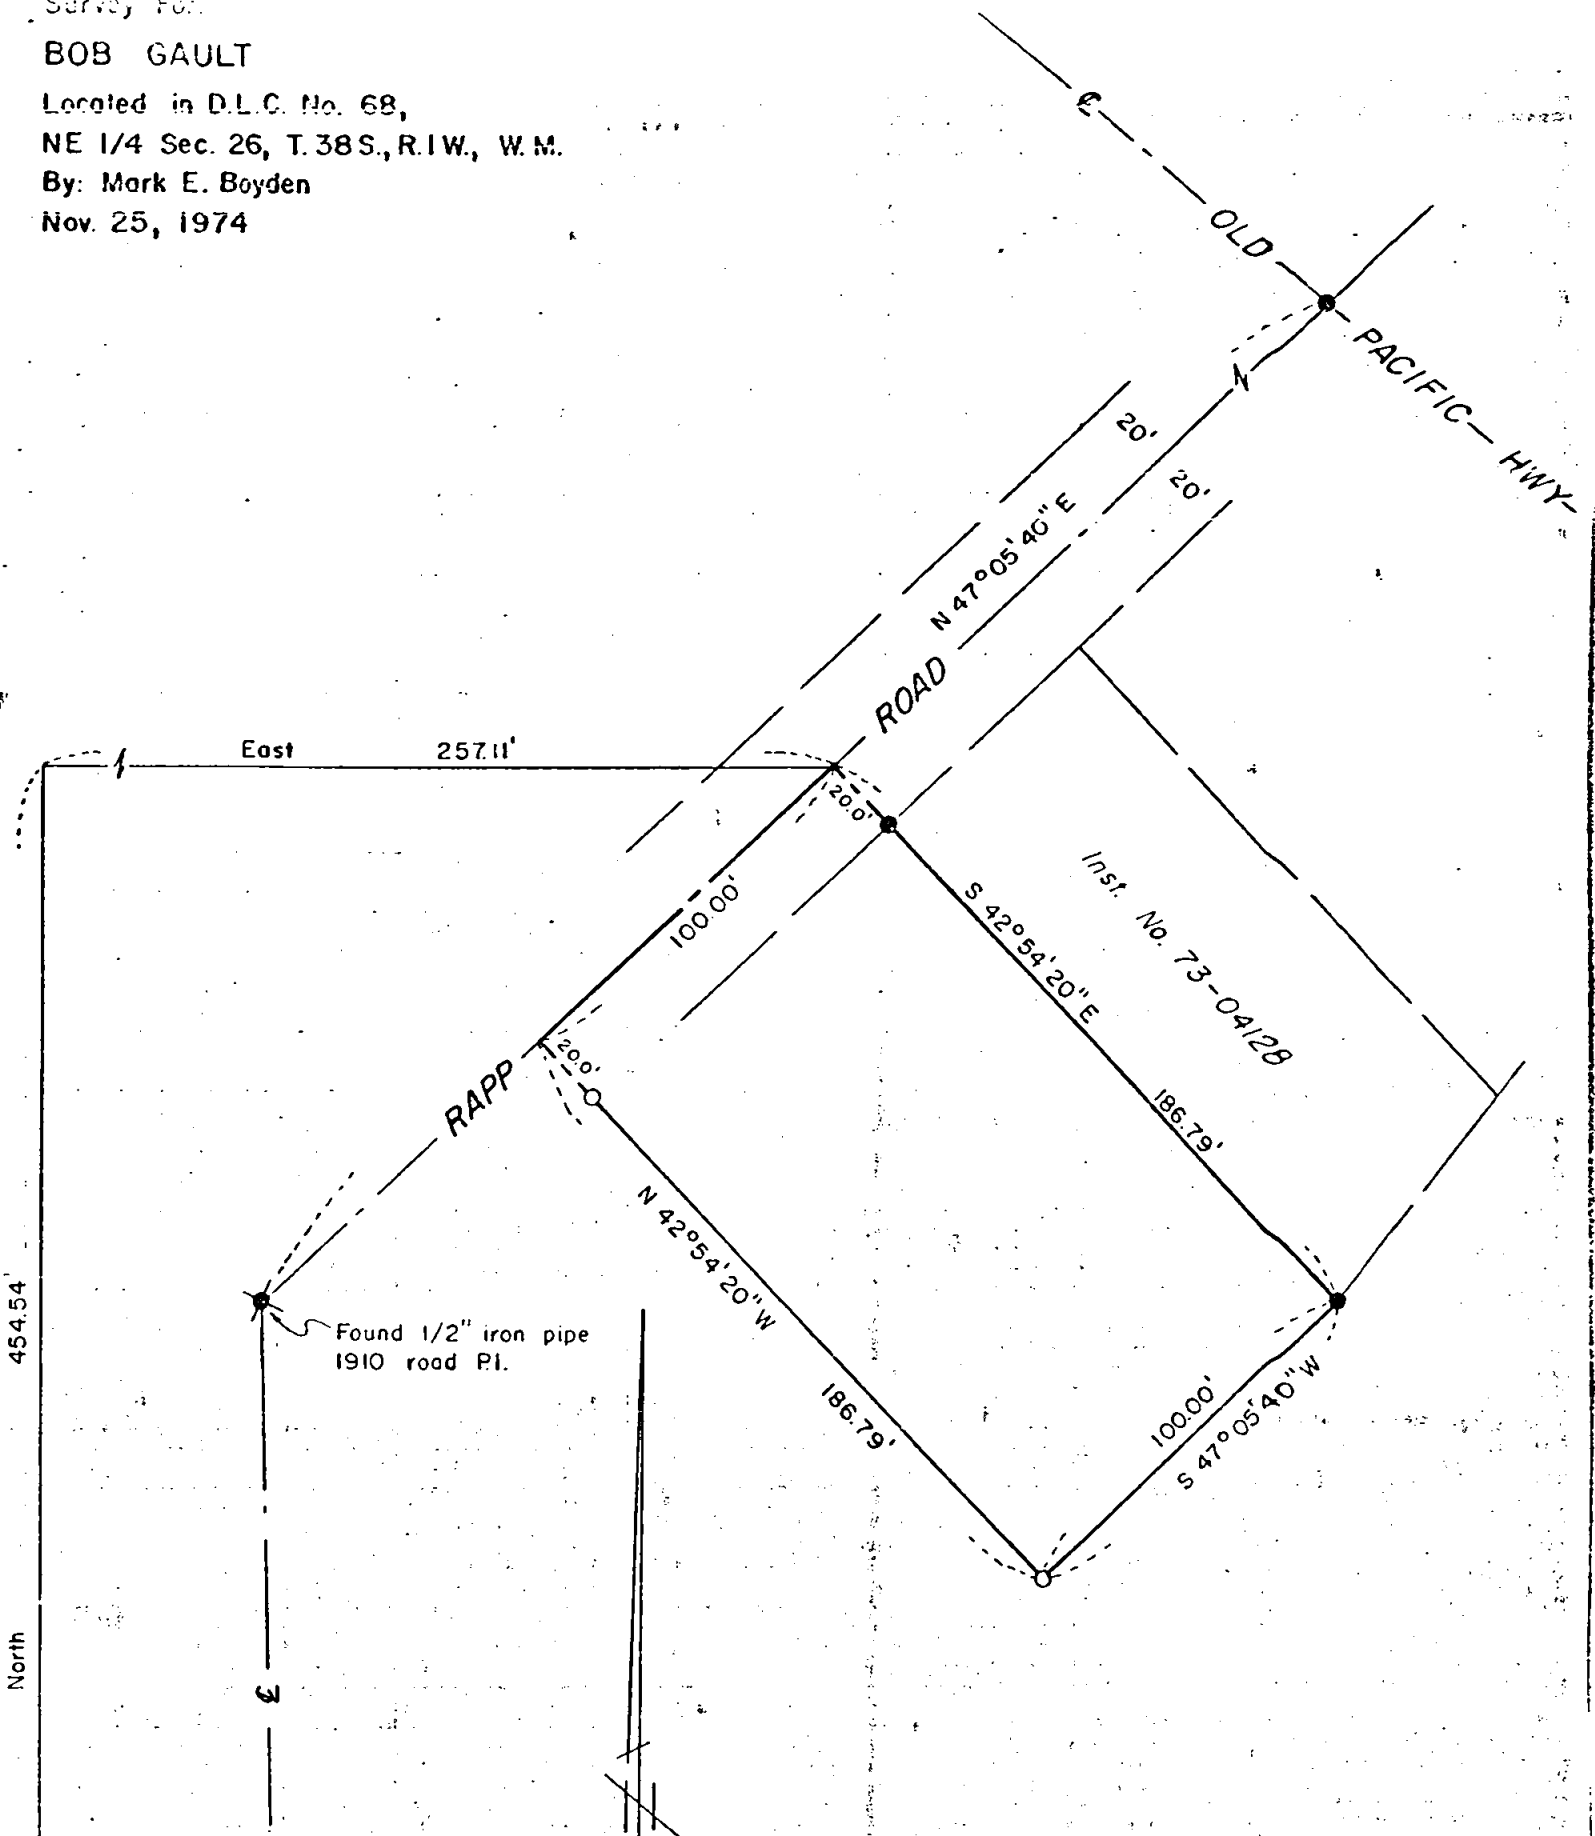


SCALE: 1" = 50'

- Found 5/8" iron pin flush set on R.S. No. 1425
- Set 3/4" X 30" iron pin flush

BASIS OF BEARINGS
RECORDED SURVEY No. 1425

SE Cor. D.L.C. No. 64
Found br. disk in conc. 9" deep

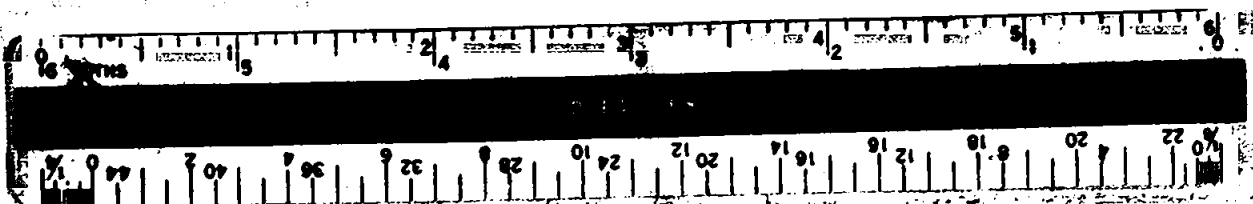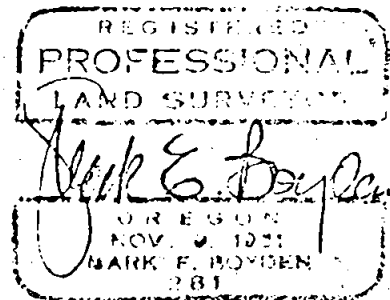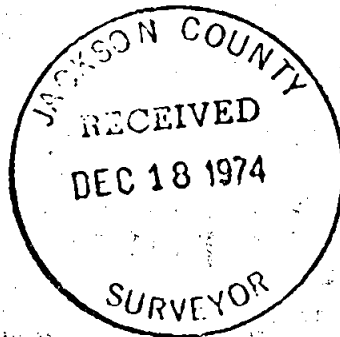

SURVEY NARRATIVE TO COMPLY WITH O.R.S. 209.250.

FOR: Bob Gault
324 Rapp Road North
Talent, Oregon

PURPOSE: To monument and describe a portion of the Harry and David, an Oregon Corporation, property lying adjacent to the tract conveyed as described in Volume 508 Deeds, Page 462 as monumented on Recorded Survey No. 1425, being located in Sec. 26, T38SR1W, W.M.

PROCEDURE: Re-checked the tie to the Southeast corner of Donation Land Claim No. 64, found monuments previously found or set on Recorded Survey No. 1425 and monumented the parcel proposed to be conveyed as shown on the annexed map.

November 25, 1974

