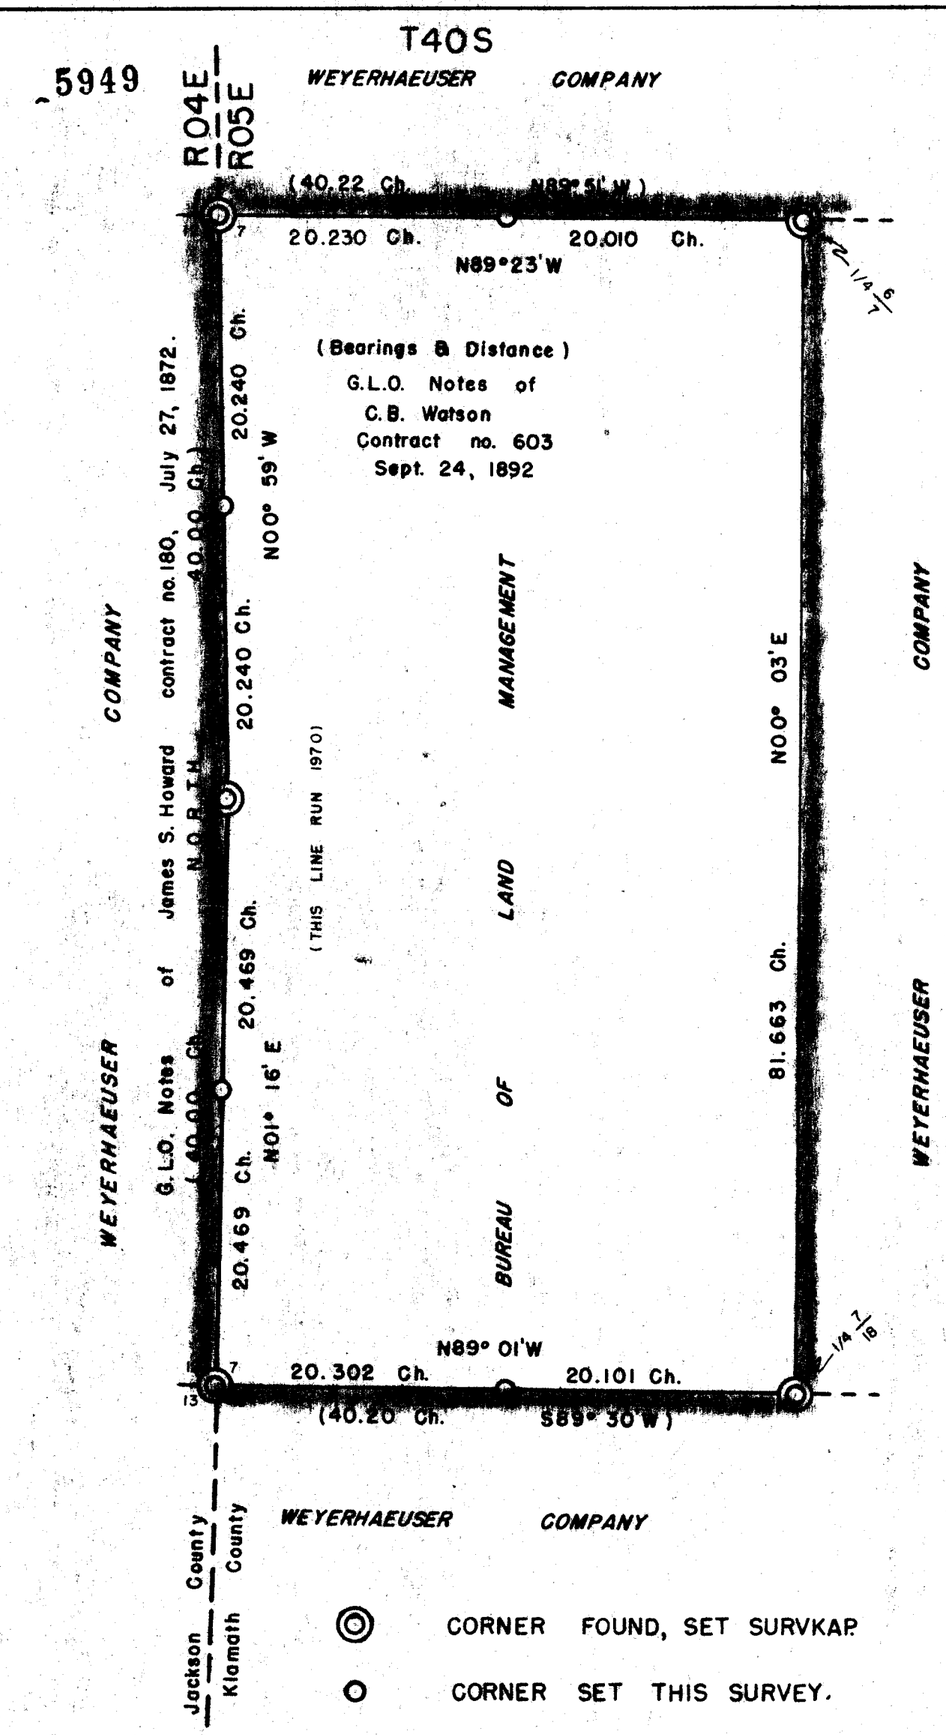

Corner Information

ALL CORNERS SET IN STONE MOUND.

ALL SURVKAP SET ATOP A 5/8" X 30" I. R.

BEARING & DISTANCE TO 'W' NAIL IN BASE OF REFERENCE TREE.

Bearings Based on Solar Observations

FILED

IN THE OFFICE OF THE KLAMATH COUNTY SURVEYOR THIS 15 DAY OF OCTOBER 1971

Francis Roberts

FRANCIS ROBERTS
Deputy County Surveyor

Surveyed by Garry Clark under the direct supervision of the late Creal H. Hammersly who expired before it could be platted and filed.

REGISTERED PROFESSIONAL LAND SURVEYOR
Everett J. Scott
OREGON
JULY 10, 1964
EVERETT J. SCOTT
661

WEYERHAEUSER
1/4 6/7
1971
ORLS 686

Found 11"x10"x8" stone, scribed '1/4' on N. face, set SurvKAP.
32" R. CEDAR, S32°E, 12.0 LKS., SCRIBED, NOT CALLED B.T.
6" S. PINE, S11°E, 33.0
5" S. PINE, N10°W, 30.5

WEYERHAEUSER
W 1/16 6/7
1971
ORLS 686

Set SurvKAP.
8" W. FIR, N86°W, 23.8 Lks.
8" W. FIR, S68° W, 10.9

WEYERHAEUSER
T40S
R4 — 5E
1 | 6
12 | 7
1970
ORLS 686

Found 18"x12"x7" stone, 5notches S. face, 1 notch N. face, set SurvKAP.
50" S. PINE, S52°E, 54.0 LKS. SCRIBED B.T. (STUMP)
30" S. PINE, N56°E, 66.0 SCRIBED B.T. (STUMP)
30" S. PINE, N66°W, 51.0 SCRIBED B.T. (STUMP)
12" S. PINE, N18°E, 61.4
14" W. FIR, S03°W, 151.4

WEYERHAEUSER
N 1/16
12 | 7
1970
ORLS 686

Set SurvKAP.
12" R. FIR, S52°E, 79.0 LKS.
10" P. PINE, S52°W, 62.5

WEYERHAEUSER
1/4
12 | 7
1970
ORLS 686

Found 10"x10"x8" stone, set SurvKAP.
30" P. PINE, N55°E, 41.0 LKS. B.T.
18" W. FIR, S30°E, 95.5
24" R. CEDAR, S85°W, 78.7

WEYERHAEUSER
S 1/16
12 | 7
1970
ORLS 686

Set SurvKAP.
8" W. FIR, N34°W, 37.0 LKS.
14" P. PINE, N44°E, 42.0

WEYERHAEUSER
T40S
R4 — 5E
12 | 7
13 | 18
1970
ORLS 686

Found 16"x10"x5" stone, 4notches S. face, 2notches N. face, set SurvKAP.
48" D. FIR, S18°E, 14.0 LKS. SCRIBED B.T.
10" P. PINE, N86°W, 52.0
12" P. PINE, N77°E, 54.6
8" P. PINE, S41° E, 99.5

WEYERHAEUSER
W 1/16 7/18
1971
ORLS 686

Set SurvKAP.

(NO REF. TREES)

1/4 7/18

Found 60"x36"x30" stone, scribed an 'X' on top.
9" P. PINE, S35°E, 16.0 LKS., SCRIBED B.T. (DEAD)
44" D. FIR, N60°W, 30.0 (20.0) SCRIBED B.T.
17" R. CEDAR, N87°E, 48.2
WITNESS CORNER, N89°01'W, 4.0 FEET

WEYERHAEUSER
W.C.
1/4 7/18 → 4'
1971
ORLS 686

Set SurvKAP.

(NO REF. TREES)

5949

RETRACE & SUBDIVISION
W1/2 Section 7, T40S, R05E W.M.
Klamath County, Oregon

Weyerhaeuser Company
Klamath Falls Branch

SCALE — 1"=10 Chains
DEL.— G.R.C.
TRACED — C.R.C.
DATE— Dec. 22, 1971
CHECKED BY— C.L.C.
DRAWING No — LS 71-11

2059