


CORNER RESTORATION

CORNER CC 30 & 31 TSP. 38S RANGE 5E

ORIGINAL SURVEY BY: Fred Mensch
U.S. Transitman
CONTRACT NUMBER: Group #6
CONTRACT DATE: 2 June, 1911

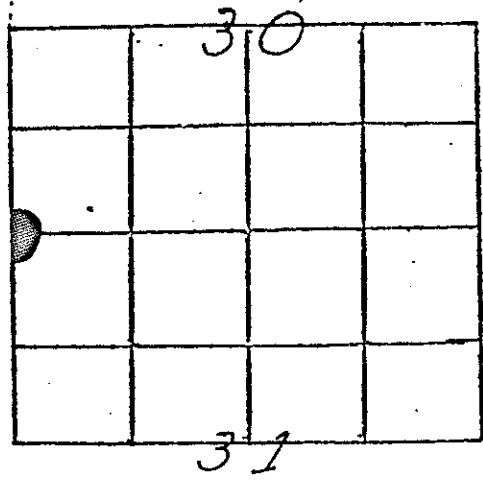

ORIGINAL DESCRIPTION:

Set a basalt stone 12" x 12" x 8" marked CC on E face with 5 grooves on N face and 1 groove on S face from which bears:
A Sugar Pine 40" in diameter, N80°E, 35.0 Lks. Scribed T38S, R5E, S30BT
A Sugar Pine 48" in diameter, S22°E, 35.0 Lks. Scribed T38S, R5E, S31BT

RESTORATION BY AND DATE:

W. DeGroot, R. Wilson, K. Lind, G. Mulvey - August 3, 1973.

EVIDENCE FOUND:

Found both B.T.s to be stumps and set 5/8" x 30" I.R. from these stumps.

DESCRIPTION OF MONUMENTS AND ACCESSORIES SET AND METHODS USED:

SHOW HOW TREES ARE SCRIBED AND BASIS OF BEARING, INCLUDING COMPASS VARIATION.

Referenced by:

- A 'W; nail set in the base of a Fir 8" in diameter, N17°W, 40.5 Lks.
- A 'W' nail set in the base of a Fir 4" in diameter, S80°W, 36.0 Lks. and built up in a mound of stone.

REGISTERED
PROFESSIONAL
LAND SURVEYOR

Everett J. Scott

OREGON
JULY 10, 1964
EVERETT J. SCOTT
661

MONUMENT STAMPED
SERVKAP

WEYERHAEUSER
38S R5E R
25 | 30
36 | 31 CC
1973
ORLS 661