


CORNER RESTORATION

CORNER Township TSP. 40-41 S RANGE 4&5E

ORIGINAL SURVEY BY: Wm. M. Turner and James Howard

CONTRACT NUMBER: 132

CONTRACT DATE: September 9, 1870

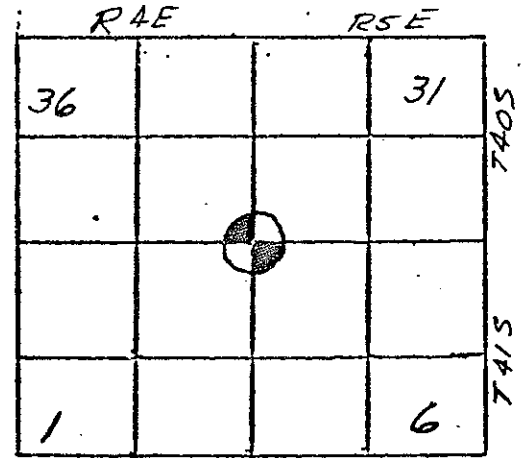

ORIGINAL DESCRIPTION: Set a post from which:
 A Cedar, 6" in diameter, bears N31°W, 100 Lks. distance
 A Fir, 18" in diameter, bears N75°E, 13 Lks. distance
 A Yellow Pine, 36" in diameter, bears S54°E, 97 Lks. distance
 A Yellow Pine, 12" in diameter, bears S60°W, 20 Lks. distance

RESTORATION BY AND DATE:

G. R. Clark, G. Mulvey, M. H. Gallagher, & D. Edwards 25 April, 1973

EVIDENCE FOUND: The Cedar to the NW is alive and 24" in diameter, the Fir to the NE is alive and 36" in diameter, the Pine to the SW is alive and 26" in diameter. The Pine to the SE is a felled stump. No evidence of the post that was called.

DESCRIPTION OF MONUMENTS AND ACCESSORIES SET AND METHODS USED:

SHOW HOW TREES ARE SCRIBED AND BASIS OF BEARING, INCLUDING COMPASS VARIATION.

Set a 5/8" x 30" I.R. from the called B.T.s also built up a mound of stone. Did not add any reference trees.

