


CORNER RESTORATION

CORNER W $\frac{1}{4}$ Section 6 TSP. 41S RANGE 5E

ORIGINAL SURVEY BY: Wm. M. Turner & James Howard

CONTRACT NUMBER: 132

CONTRACT DATE: Sept. 9, 1870

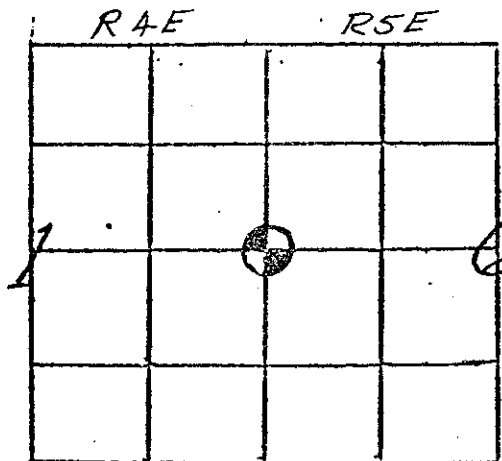

ORIGINAL DESCRIPTION: Set a post from which:
 A Yellow Pine, 12" in diameter, bears N75 $\frac{1}{2}$ ⁰W, 23 Lks. distance
 A Cedar, 8" in diameter, bears N72 $\frac{1}{2}$ ⁰E, 43 Lks. distance

RESTORATION BY AND DATE:

G. R. Clark, G. Mulvey, M. H. Gallagher, & D. Edwards

26 April, 1973

EVIDENCE FOUND: The Cedar in the NE is alive and 18" in diameter, the Pine in the NW is dead and down. Scribing was visible in both B.T.s.

DESCRIPTION OF MONUMENTS AND ACCESSORIES SET AND METHODS USED:

SHOW HOW TREES ARE SCRIBED AND BASIS OF BEARING, INCLUDING COMPASS VARIATION.

Set a 5/8" x 30" I.R. from the B.T.s and built up a mound of stone. Referenced to a 'W' nail set in the base of a Cedar 18" diameter that bears N20⁰W, and is 38.9 Lks. distance.

REGISTERED
 PROFESSIONAL
 LAND SURVEYOR

Everett J. Scott

OREGON
 JULY 10, 1964
 EVERETT J. SCOTT
 661