1329.

FOUND I" IRON PIPE MARKING

THE S. 16 COR. ON THE WESTERLY LINE OF SEC. 7

685.71

FOUND 5/8" PIN -

5 89°43'51"E

1371.42

FOUND %"PIN"

685.71

FOUND %" PIN 0.06' N. OF LINE

--- (REC.= 589°43'40"E

SET I' IRON PIPE AT THE

2701.16')---


ī

332.

CTR. S.W. 1/16 COR. OF SEC. 7

589°43'51"E 1

1329.87

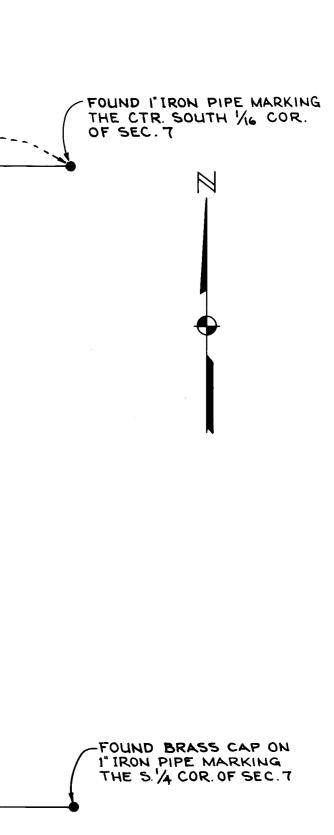

SURVEY * 2881

686.001

RECEIVED
MAR 2 4 1975

LEGEND:

686.00'

- FOUND 2½" IRON PIPE MARKING THE S.W. COR.

OF SECTION T

● = FOUND MONUMENT AS SHOWN.

1372.00

(REC.= 1372.19')

Ø = SET MONUMENT AS SHOWN.

0 = SET 3/4" IRON PIPE

N 89°40'40"W

BASIS OF BEARINGS = SOUTH LINE OF THE S.W. 1/4 OF THE S.W. 1/4 OF SEC. 7 AS PER SURVEY NO. 2881

N 00,08,01"E

PROFESSIONAL
LAND SURVEYOR

OREGON
JULY 16, 1971
LARRY J. FRIAR
961

FOUND I" IRON PIPE MARKING THE W. 1/6 COR. ON THE SOUTHERLY

LINE OF SEC. T

PLAT OF SURVEY

BEDFORD CURRIER

BEING THE SOUTHWEST ONE-QUARTER OF THE SOUTHWEST ONE-QUARTER OF SEC.T, T.35S., R.IW., W.M. JACKSON CO. SCALE:1"=200' OREGON DATE: MAR.1975

PREPARED BY: FRIAR-MOFFIT SURVEYING MEDFORD, OREGON

5963

5963

SURVEY NO.

SURVEY NARRATIVE TO COMPLY WITH O. R. S. 209.250

SURVEY FOR:

Bedford Currier 3964 Beagle Road

Central Point, Oregon

LOCATION:

S.W. $\frac{1}{4}$ of Section 7, T.35S., R.1W., W.M.,

Jackson County, Oregon.

PURPOSE:

To monument lines on clients property as

shown on the attached map.

PROCEDURE:

Found monuments set on Survey's Number 2881 and 3295 at the South 1/16 Corner on the West line of Section 7, the West 1/16 Corner on the South line of Section 7, and the Center South 1/16 Corner of Section 7, the corners were tied together and found to be within acceptable accuracy,

and were used.

The Southwest 1/16 corner was established at a proportional distance on line between

the found 1/16 Corners East and West.

Set and found monuments as shown on the

attached map.

DATE:

Feburary, 1975

Larry J. Friar Professional Land Surveyor

RECEIVED
MAR 2 4 1975

SURVEYOR

REGISTERED
PROFESSIONAL
LAND SURVEYOR

OREGON
JULY 16, 1971
LARRY 9, FRIAR
961