

5981

SURVEY FOR JAMES NISTLER

SEC. 14, T. 37S., R. 2W., W.M.

CITY OF MEDFORD, OREGON

January 31, 1975



SCALE 1" = 50'

LEGEND

- o 5/8x24" Iron Pin Set
- Monument Found

60.00 INITIAL POINT B. CAP MONUMENT

ELLENDALE SUBDIVISION

3

UNIT NUMBER 3

STREET

MARILEE

SOUTH

134.92

42.34

S45°06'35"E


REGISTERED PROFESSIONAL LAND SURVEYOR

*Verlyn Thomas*

OREGON  
MAY 13, 1960  
VERLYN D. THOMAS  
505

DAN AVENUE

EAST 102.85

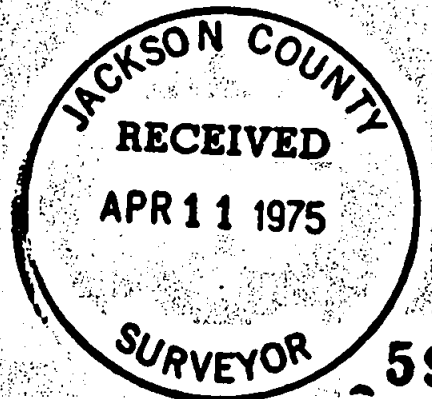

SURVEY BY VERLYN THOMAS, PROFESSIONAL LAND SURVEYOR, MEDFORD, OREGON.

SURVEY NARRATIVE TO COMPLY WITH O.R.S. 209.250  
REVISED BY CHAPTER 555, O.L. 1963

FOR: James Nistler  
406 West Main  
Medford, Oregon

PURPOSE: To survey and monument a division line as instructed  
by client.

PROCEDURE: Recovered monuments as shown on the accompanying plat,  
and monumented division line.

