


5997
15-114

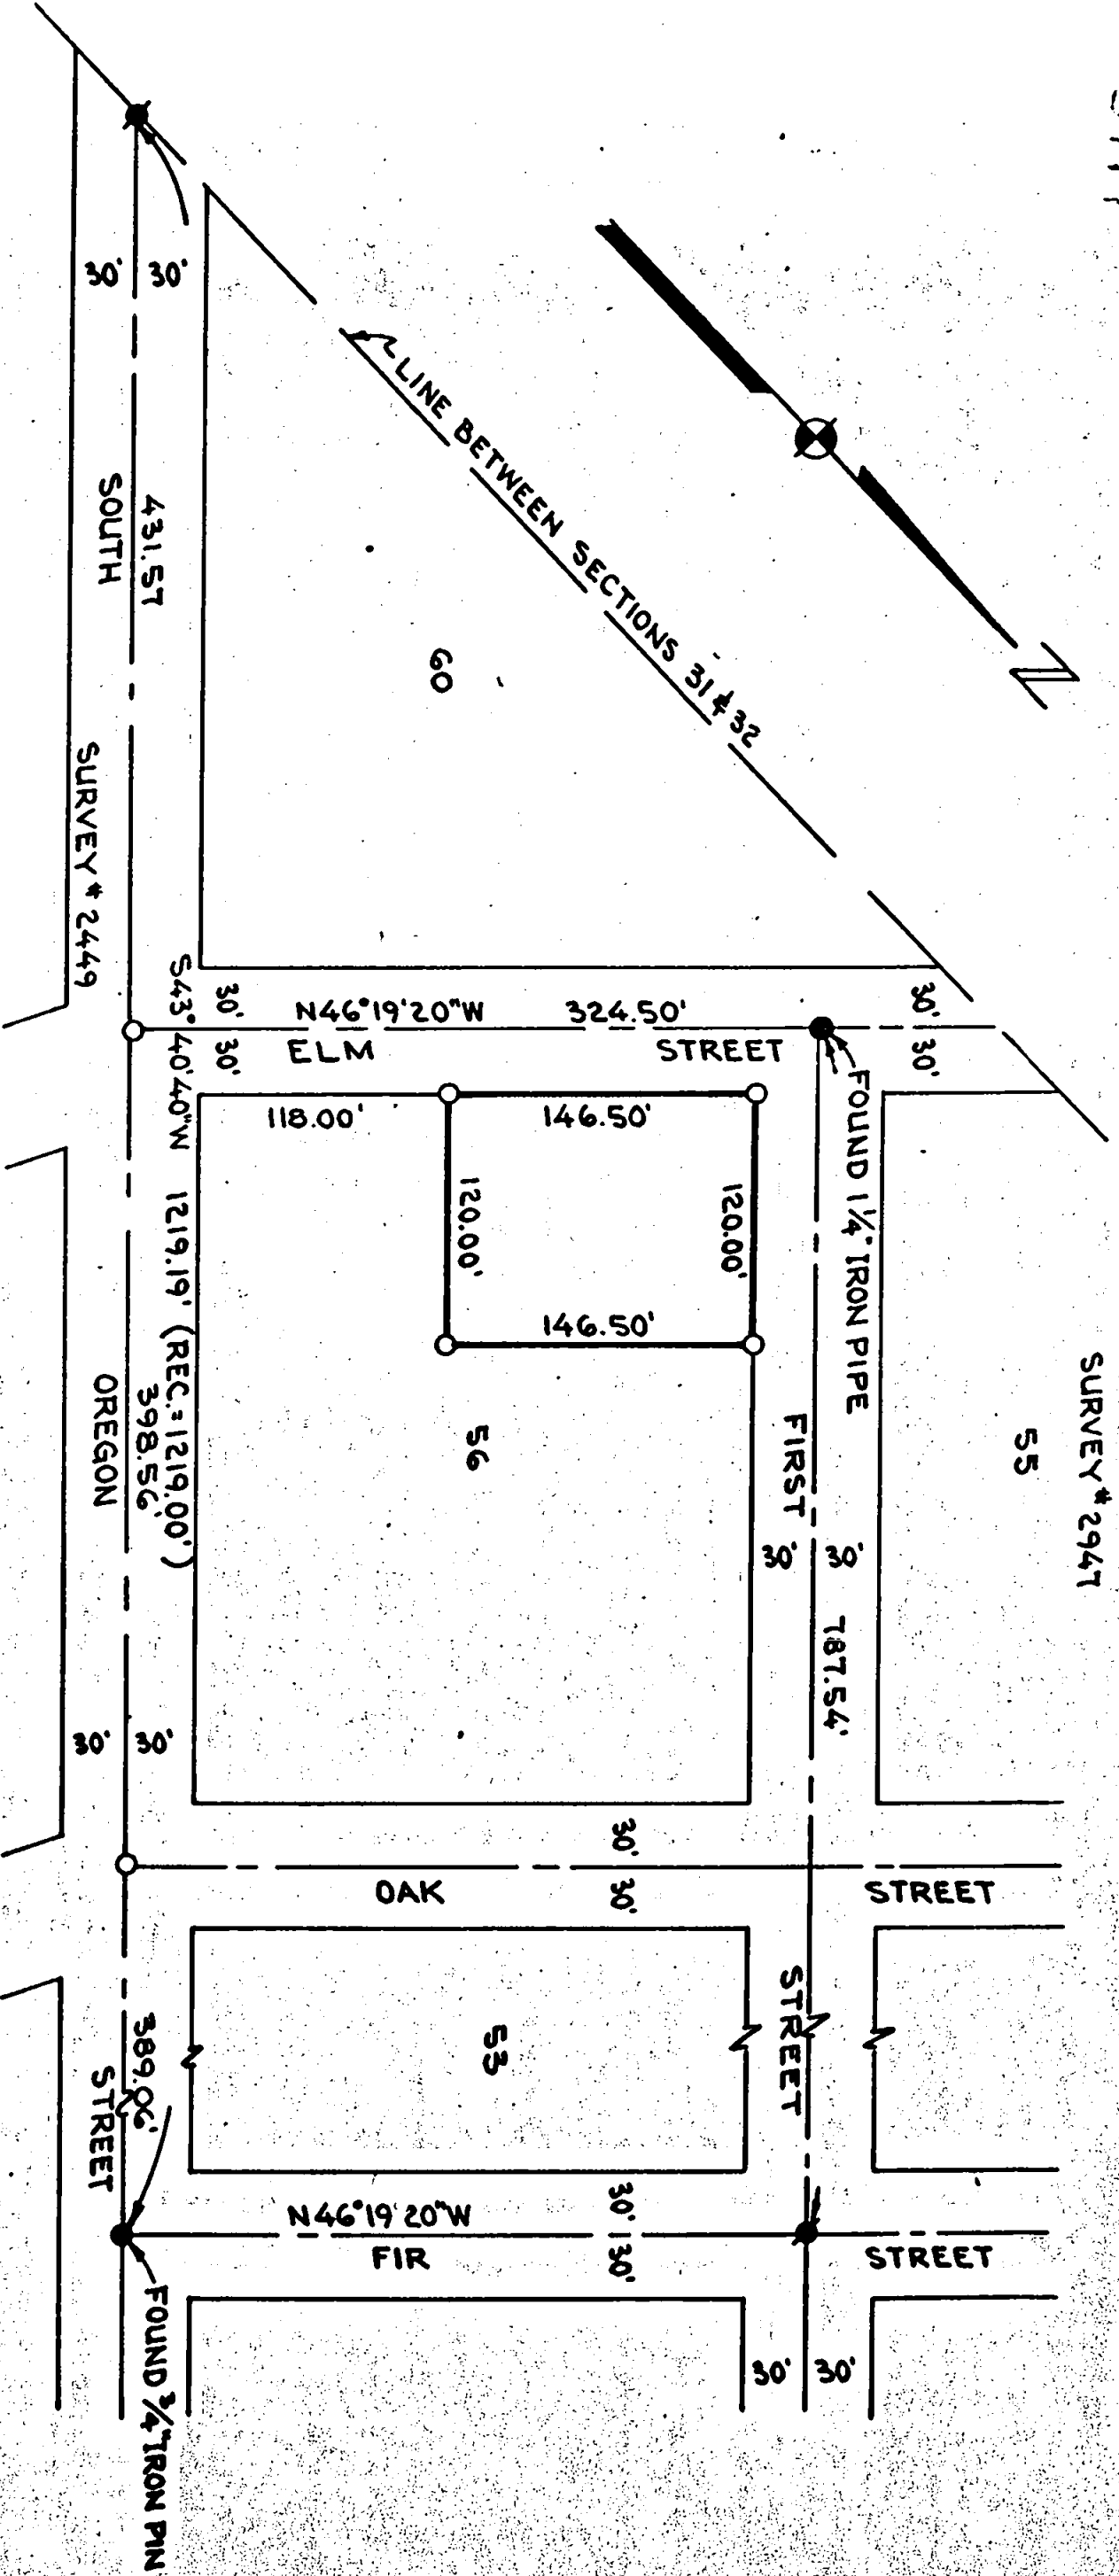

RECEIVED
APR 25 1975
JACKSON COUNTY
SURVEYOR


LEGEND:
 ● FOUND MONUMENT AS SHOWN
 ○ FOUND 5/8" IRON PIN
 ○ SET 5/8" IRON PIN

REGISTERED
 PROFESSIONAL
 LAND SURVEYOR
James F. Friar
 OREGON
 JULY 16, 1971
 LARRY J. FRIAR
 9 61

PLAT OF SURVEY
 FOR
JAMES F. MADISON

BEING A PORTION OF BLOCK 56
 OF THE ORIGINAL TOWN OF
 JACKSONVILLE, IN THE NW 1/4
 OF SECTION 32, T.37S., R.2W., W.M.
 JACKSON CO.
 OREGON
 SCALE: 1"=100'
 DATE: APRIL, 1975
 PREPARED BY: FRIAR-MOFFIT SURVEYING

5997 15-114

 

SURVEY NO. 5997

SURVEY NARRATIVE TO COMPLY WITH O. R. S. 209.250

SURVEY FOR: James F. Madison
370 Elm Street
Jacksonville, Oregon

LOCATION: Block 56, Original Town of Jacksonville, Oregon.

PURPOSE: To monument corners of clients property.

PROCEDURE: Found monuments set by Survey no. 2449 on the centerline of Oregon Street at the intersection of the Section Line between Sections 31 and 32, and at Fir Street. The intersections of Elm Street and Oak Street were then set at proportional distances, the centerline of Elm Street was established at right angles to Oregon Street. A 1½ inch iron pipe, badly bent, was found at the intersection of Elm and First Street. This pipe was straightened and replaced at record distance from Oregon Street.

The corners of the parcel were set as shown on the attached map.

Electronic distance measuring equipment and a one second theodolite was used on this survey.

DATE: April 14, 1975

Larry J. Friar
Professional Land Surveyor

REGISTERED
PROFESSIONAL
LAND SURVEYOR

Larry J. Friar

OREGON
JULY 16, 1971
LARRY J. FRIAR
961

JACKSON COUNTY
RECEIVED
APR 25 1975
SURVEYOR

532 T372W