
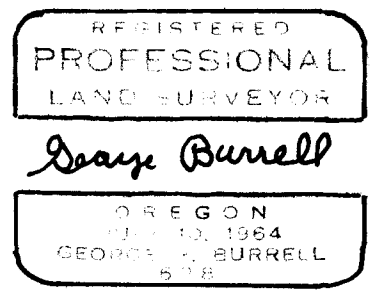


LEGEND

- = Found 5/8" Iron Pin
- = Set 5/8" I. Pin (tagged R.L.S. 638)

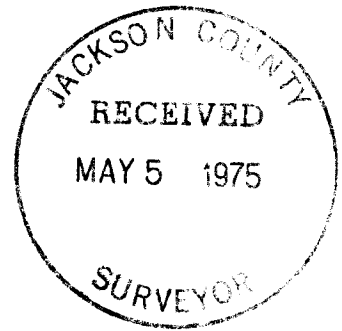

MAP OF SURVEY
 Located in N.W. 1/4 Section 9, T38S, R1W
 For: D. HENDRIX and R.E. DAVIS, MEDFORD
 By: George Burrell, Surveyor, Apr. 1975

SURVEY NO. 6008

SURVEY NARRATIVE TO COMPLY WITH O.R.S. 209.250

FOR: D.Hendrix and R.E. Davis
3722 S. Pacific Hwy.
Medford, Oregon

PURPOSE: To monument 3 tracts of record as shown on the accompanying map.

PROCEDURE: The monuments of Recorded Surveys No. 3950 and 5403 which established the North and South boundaries of said tracts were recovered and held as control in establishing said record boundaries.

