

6052

24 25 EAST 1176.09'  
1/4 SECTION CORNER  
FD. 2" METAL DISK  
in SANDSTONE LEDGE

NORTH

R.W. INTERSTATE SOUTH 1410.27'  
110.55' 53.20' 94.28'  
HIGHWAY No. 5  
HIGHWAY 99S  
RECORDED SURVEY  
No. 5344

MAP OF SURVEY  
LOCATED IN  
E 1/2 OF SEC. 25, TWP. 39S., R. 1E.W.M.  
JACKSON COUNTY OREGON  
FOR

# JACK THOMPSON

EVERETT L. SWAIN, R.L.S.

ASHLAND, OREGON

SCALE: 1" = 100'

JUNE 2, 1975

BASIS OF BEARING:



N. O. A. A. TRUE BEARING N-S @ SEC. 25

• FOUND 5/8 INCH IRON PIN UNLESS OTHERWISE SHOWN

932.16'  
1321.28'  
1291.71'  
N. 00° 01' 40" W.  
S. 00° 01' 40" E.

WAY  
PRIVATE

RECORDED SURVEY  
No. 5302

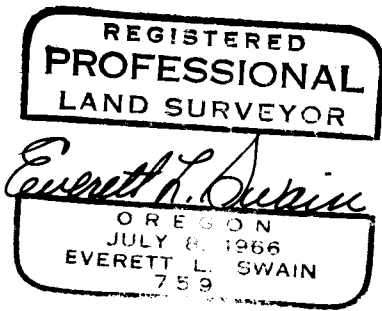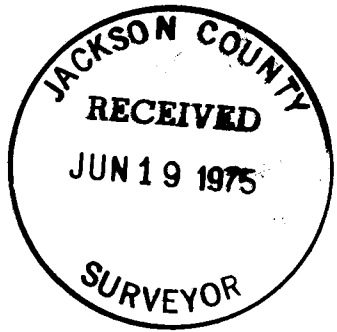


CENTER SECTION  
FD. 3/4" I. PIN  
12" deep  
R.S. No. 3365

S. 89° 47' 06" W.

1119.88'

$\Delta = 64^{\circ} 37' 23''$   
R = 20.00'  
L = 22.56'

389.12'

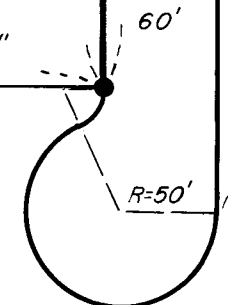

$\Delta = 244^{\circ} 37' 23''$   
L = 213.47'

6052

SURVEY NO. **6052**

SURVEY NARRATIVE TO COMPLY WITH PARAGRAPH 209.250  
OREGON REVISED STATUTES

SURVEY FOR: Jack Thompson  
P. O. Box 654  
Ashland, Oregon 97520

LOCATION: Situated in the East half of Section 25, Township 39 South,  
Range 1 East of the Willamette Base and Meridian, Jackson County,  
Oregon.

PURPOSE: To map and show the location of a "Creation of a Private Way"  
as approved by the Jackson County Planning Commission.

PROCEDURE: From information compiled by this office previously proceeded  
to map the location of said Private Way as shown.

June 2, 1975

Everett L. Swain  
Professional Land Surveyor  
Ashland, Oregon

