

6064

BUREAU OF LAND MANAGEMENT
T 39 S
W E Y E R H A E U S E R
C O M P A N Y
R 0 4 E

(Originally surveyed by Sewel Truax, Contract no. 80, July 8, 1959)

(North 40.00 chs.)



1326.975'

1326.975'

S 00° 03' E



Bearings based on solar observation

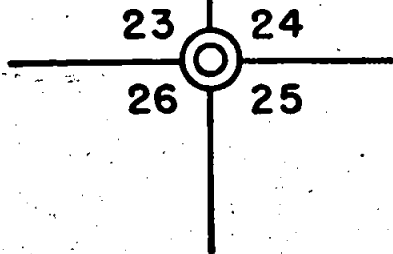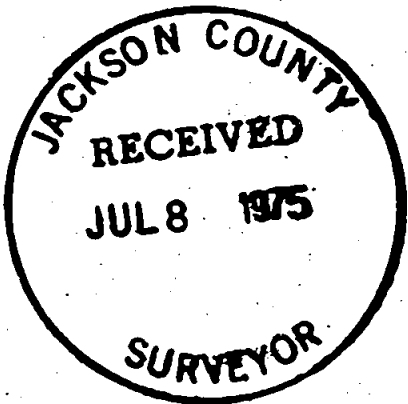

REGISTERED PROFESSIONAL LAND SURVEYOR

Everett J. Scott

OREGON
JULY 10, 1964
EVERETT J. SCOTT
661

- ⊙ CORNERS FOUND.
- CORNERS SET.
- ⊙ CORNERS FOUND RESET.

RETRACE & SUBDIVISION
South 1/2, East line, Sec. 23, T 39 S, R 04 E, W.M.
JACKSON COUNTY, OREGON.



Weyerhaeuser Company

Klamath Falls Branch

SCALE — 1" = 400'
DEL. — Y.K.F.
TRACED — Y.K.F.

DATE — 10 JULY 1974
CHECKED BY —
DRAWING NO. — LS74-11

6064

6064



WEYERHAEUSER COMPANY
KLAMATH FALLS BRANCH

Retrace & Subdivision
South $\frac{1}{2}$, East Line, Section 23, T39S, R04E, W.M.
Jackson County, Oregon

23	24
26	25

Found Corner as set by Cadastral Surveyors, 1966. Did not further perpetuate.

S 1/16	
23	24

Set a SurvKAP on a 5/8" x 30" iron rod from which bears:
A White Fir 10" in diameter, S30⁰E, 10.8 Lks.
A White Fir 8" in diameter, S80⁰W, 18.6 Lks.

$\frac{1}{4}$	
23	24

Set a SurvKAP on a 5/8" x 30" iron rod from found B.T.'s which bears:
A Pine 26" in diameter, S80⁰E, 5.0 Lks. (Decaying stump notched)
A Pine 22" in diameter, S78⁰W, 11.0 Lks. (Decaying stump notched)
Set additional references:
A Douglas Fir 14" in diameter, S76⁰E, 44.7 Lks.
A Douglas Fir 10" in diameter, N02⁰W, 54.3 Lks.

All SurvKAPS are set in a stone mound and are stamped:

WEYERHAEUSER


1974
ORLS 661

All bearings and distances are to 'W' nails set in the base of the described tree.

Everett J. Scott

Everett J. Scott

1 of 1

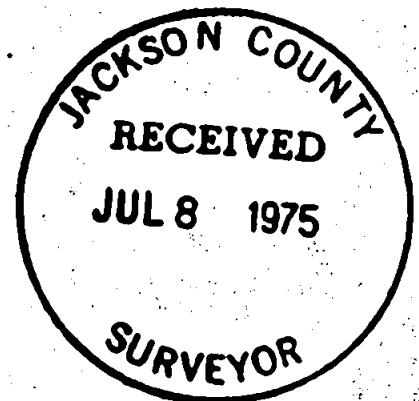

S 23 T39S R4E