

1/4 SECTION CORNER
 Fd. 1" I. Pipe, exp. 8 1/2" - 1
 w/5/8" I. Pin w/alum. cap
 inside pipe
 per R.S. No. 801 B 5637

E 1/16 CORNER
 Fd. 5/8" I. Pin
 logged RLS 638
 per R.S. No. 4815

SECTION CORNER
 Fd. 2" G.I. Pipe
 CS Re-est'd

NE 1/16 CORNER
 Set 1" x 30" G.I. Pipe, exp. 2",
 w/2 1/2" Br. Cap mtd.
 SWAIN SURVEYING
 T385 RIW
 NE 1/16 COR
 PLS 759
 SURVEY MONUMENT 1974

Fd. 5/8" I. Pin
 b/s S. 89° 32'
 15" E. 0.23

NORTH

1/4 SECTION CORNER
 Fd. 5/8" I. Pin w/1" G.I. Pipe
 driven over 100, exp. 5",
 w/Br. Cap

1/4 SECTION CORNER
 Sec. 33 only
 Fd. 1" G.I. Pipe, exp. 7"
 w/C.S. Br. Cap

CE 1/16 CORNER
 Set 1" x 36" G.I. Pipe, exp. 6",
 w/2 1/2" Br. Cap mtd.
 SWAIN SURVEYING
 T385 RIW
 E 1/16 CORNER
 PLS 759
 SURVEY MONUMENT 1974

1/4 SECTION CORNER
 Fd. 5/8" I. Pin, 4 deep
 per R.S. No. 1786

MAP OF SURVEY
 LOCATED IN
 SE 1/4 OF NE 1/4 OF SEC. 33, TWP. 38S, RIW. W
 JACKSON COUNTY OREGON
 FOR

MIKLOS GYENES


EVERETT L. SWAIN, R.L.S.

ASHLAND, OREGON

SCALE: 1" = 400'
 BASIS OF BEARING: N.O.A. TRUE BEARING AT N-S & OF SEC. 33
 FOUND MONUMENTS AS SHOWN
 SET 5/8" x 24 INCH IRON PIN UNLESS OTHERWISE SHOWN

JACKSON COUNTY
 RECEIVED
 SEP 10 1975
 SURVEYOR

REGISTERED
 PROFESSIONAL
 LAND SURVEYOR
 OREGON

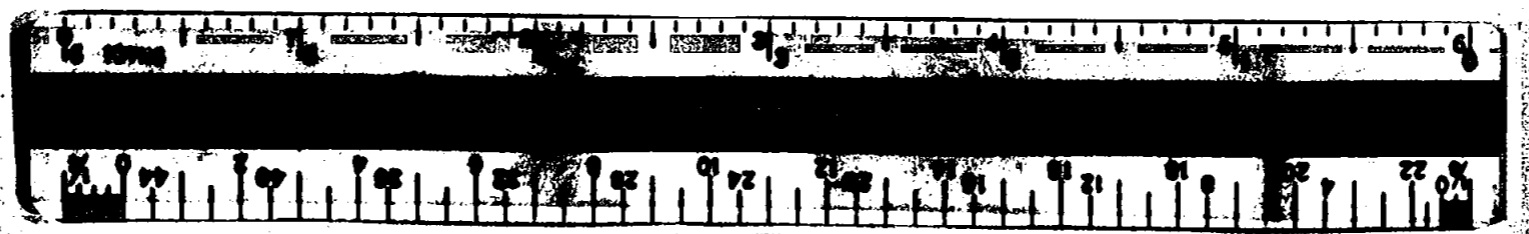

SURVEY NO. 6120

SURVEY NARRATIVE TO COMPLY WITH PARAGRAPH 209.250
OREGON REVISED STATUTES

SURVEY FOR: Miklos Gyenes
1828 Anderson Creek Road
Talent, Oregon 97540

LOCATION: Situated in the Southeast quarter of the Northeast quarter of
Section 33, Township 38 South, Range 1 West of the Willamette Base
and Meridian, Jackson County, Oregon.

PURPOSE: To survey and monument those boundaries as shown on the accompanying
map per legal descriptions furnished by the client.

PROCEDURE: From previously established control proceeded to survey and monument
the boundary as shown.

Center-East sixteenth corner

At the corner point set a 36 inch long by 1 inch diam. galvanized
iron pipe, 30 inches in the ground, with a 2 1/2 inch bronze
cap mkd:

Swain Surveying
T38S R1W
E 1/16 c—c
PLS 759
Survey Monument 1974

from which

A P. Pine, 12 inches in diam., bears S.86°33'E., 19.1 feet
dist., scribed CE 1/16 S33 BT

A R. Fir, 19 inches in diam., bears N.13°35'W., 30.6 feet
dist., scribed CE 1/16 S33 BT.

Evidence of a previous blazed line which bears North and South.

Northeast sixteenth corner

At the corner point set a 30 inch long by 1 inch diam. galvanized
iron pipe, 28 inches in the ground, with a 2 1/2 inch diam.
bronze cap mkd.

Swain Surveying
T38S R1W
NE 1/16 ——— Cor
PLS 759
Survey Monument 1974

from which


A Laurel, 12 inches in diam., bears S.12°27'E., 26.35 feet
dist., scribed NE 1/16 S33 BT.

A W. Oak, 5 inches in diam., bears N.72°44'W., 19.35 feet
dist., scribed NE 1/16 S33 BT.

A N-S fence bears East, 0.5 feet, m.o.l.

A fence corner of fences bearing North-South and East, bears
South, 6.5 feet, m.o.l.


Found a 5/8 inch iron pin per Recorded Survey No. 3263 which
bears S. 30°14'E., 14.13 feet dist.

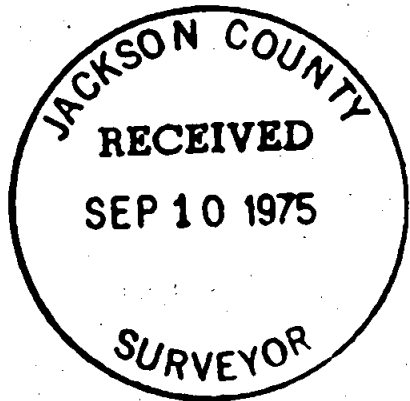

August 10, 1975



Everett L. Swain

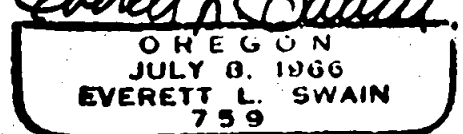

Everett L. Swain
Professional Land Surveyor
Ashland, Oregon

S33 T38 R1W