

6167

LEGEND:

- = FOUND MONUMENT AS SHOWN.
- = SET IRON PIN WITH PLASTIC CAP

BASIS OF BEARINGS:

SURVEY NUMBER 3505

FD. 1 1/2" IRON PIPE MARKING THE N 1/4 COR. OF SEC. 29

FD. BRASS CAP MARKING THE "L" COR. D.L.C.*69

FOUND NAIL

FD. 1 1/2" IRON PIN MARKING THE E.S.E. COR. D.L.C.*69



REGISTERED
PROFESSIONAL
LAND SURVEYOR

Larry J. Friar


OREGON
JULY 16, 1971
LARRY J. FRIAR
9 61

FD. 1" IRON PIPE MARKING THE S 1/4 COR. OF SEC. 29

PLAT OF SURVEY
FOR
EUGENE HANSON

BEING A PORTION OF THE
SOUTHWEST ONE-QUARTER
OF SECTION 29, T.36S., R.2W., W.M.
JACKSON CO. SCALE: 1"=100'
OREGON DATE: AUG. 1975

PREPARED BY: FRIAR-MOFFIT SURVEYING
MEDFORD, OREGON

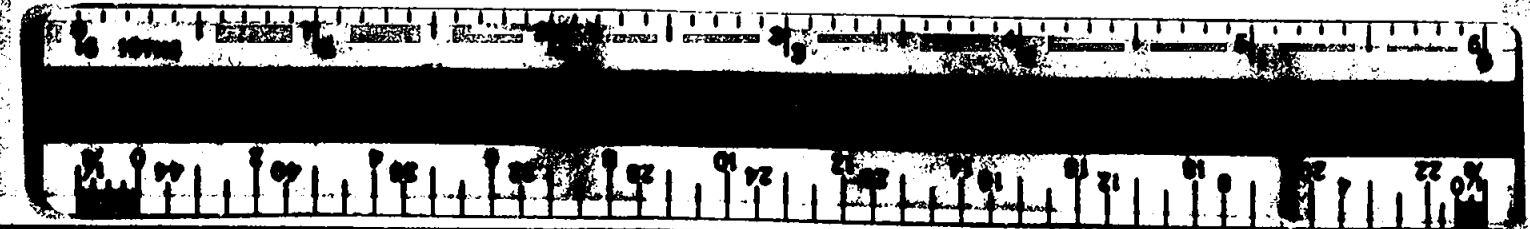

6167

SURVEY NO. 6167

SURVEY NARRATIVE TO COMPLY WITH O. R. S. 209.250

SURVEY FOR: Eugene G. Hanson
6038 Tolo Rd.
Central Point, Oregon

LOCATION: S. W. $\frac{1}{4}$ Section 29, Township 36
South, Range 2 West, Willamette
Meridian, Jackson County, Oregon.

PURPOSE: To survey and monument two five-
acre Parcels.

PROCEDURE: Traversed from the North $\frac{1}{4}$ corner
of Section 29 through the E. S. E.
corner of D. L. C. 69, the inside
ell. corner of D. L. C. 69 and the
South $\frac{1}{4}$ corner of Section 29. Closed
traverse back to the E. S. E. corner
of D. L. C. 69, utilizing H. P. Dis-
tance Meter and one second Theodolite.
The centerline location of Baldwin
Street as established by Survey
No. 1975 was accepted and used in
this Survey.
Closed traverses were run around
subject Parcels and monuments set
as shown.

DATE: August, 13, 1975

REGISTERED
PROFESSIONAL
LAND SURVEYOR
Larry J. Friar
OREGON
JULY 16, 1971
LARRY J. FRIAR
961

JACKSON COUNTY
RECEIVED
OCT 8 1975
SURVEYOR

Larry J. Friar
Professional Land Surveyor

S29 T36 2W