

PROPERTY SURVEY
 SITUATE IN
 SW 1/4 SEC 3 T 35 S R 4 W WM
 JACKSON COUNTY OREGON
 G W PLUMB LAND SURVEYOR
 MEDFORD OREGON 10 OCT 1975



BEARINGS FROM WEST PROP LINE RS 4982
 ○ FOUND 5/8" IRON ROD
 ● SET 5/8" X 24" IRON ROD
 SCALE 1" = 200'

REGISTERED
 PROFESSIONAL
 LAND SURVEYOR

G. W. Plumb
 OREGON
 JULY 12, 1968
 G. W. PLUMB
 862

6176

Survey for Wayne D. Robinson
333 Earhart Road
Rogue River, Oregon 97537


C. E. Harpham
1062 Pleasant Creek Road
Rogue River, Oregon 97537

Survey by G. W. Plumb, Land Surveyor
P. O. Box 904
Medford, Oregon 97501

Location SW. $\frac{1}{4}$ Section 3, T. 35 S., R. 4 W., W. M., Jackson
County, Oregon

Found 2" iron pipe for SW cor. Sec. 3, and 1" iron pipe for $\frac{1}{4}$ cor.
on S. line of Sec. 3. Found $\frac{5}{8}$ " iron rods for west line of property
per Registered Survey No. 4982. Found $\frac{5}{8}$ " iron rods set for SE cor
of property per R. S. 4982, and for CS $\frac{1}{16}$ cor of Sec. 3 per R. S.
4777. Using the West line of property per R. S. 4928 for bearing,
traversed the south line of the SW $\frac{1}{4}$ of Sec. 3; and the SE $\frac{1}{4}$ of the
SW $\frac{1}{4}$ of said Sec. 3. The boundary of the SE $\frac{1}{4}$ of the SW $\frac{1}{4}$ could not be
reconciled with the records of R. S. 4777 or of R. S. 4928.

Set $\frac{5}{8}$ " x 24" iron rods per deed records as shown on the accompany-
ing map, and to divide the south parcel in half,

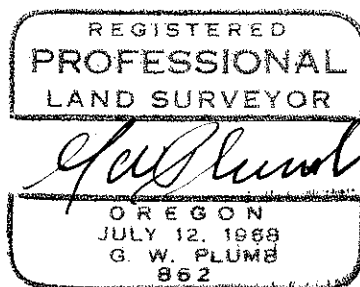

10 October 1975

