


6182

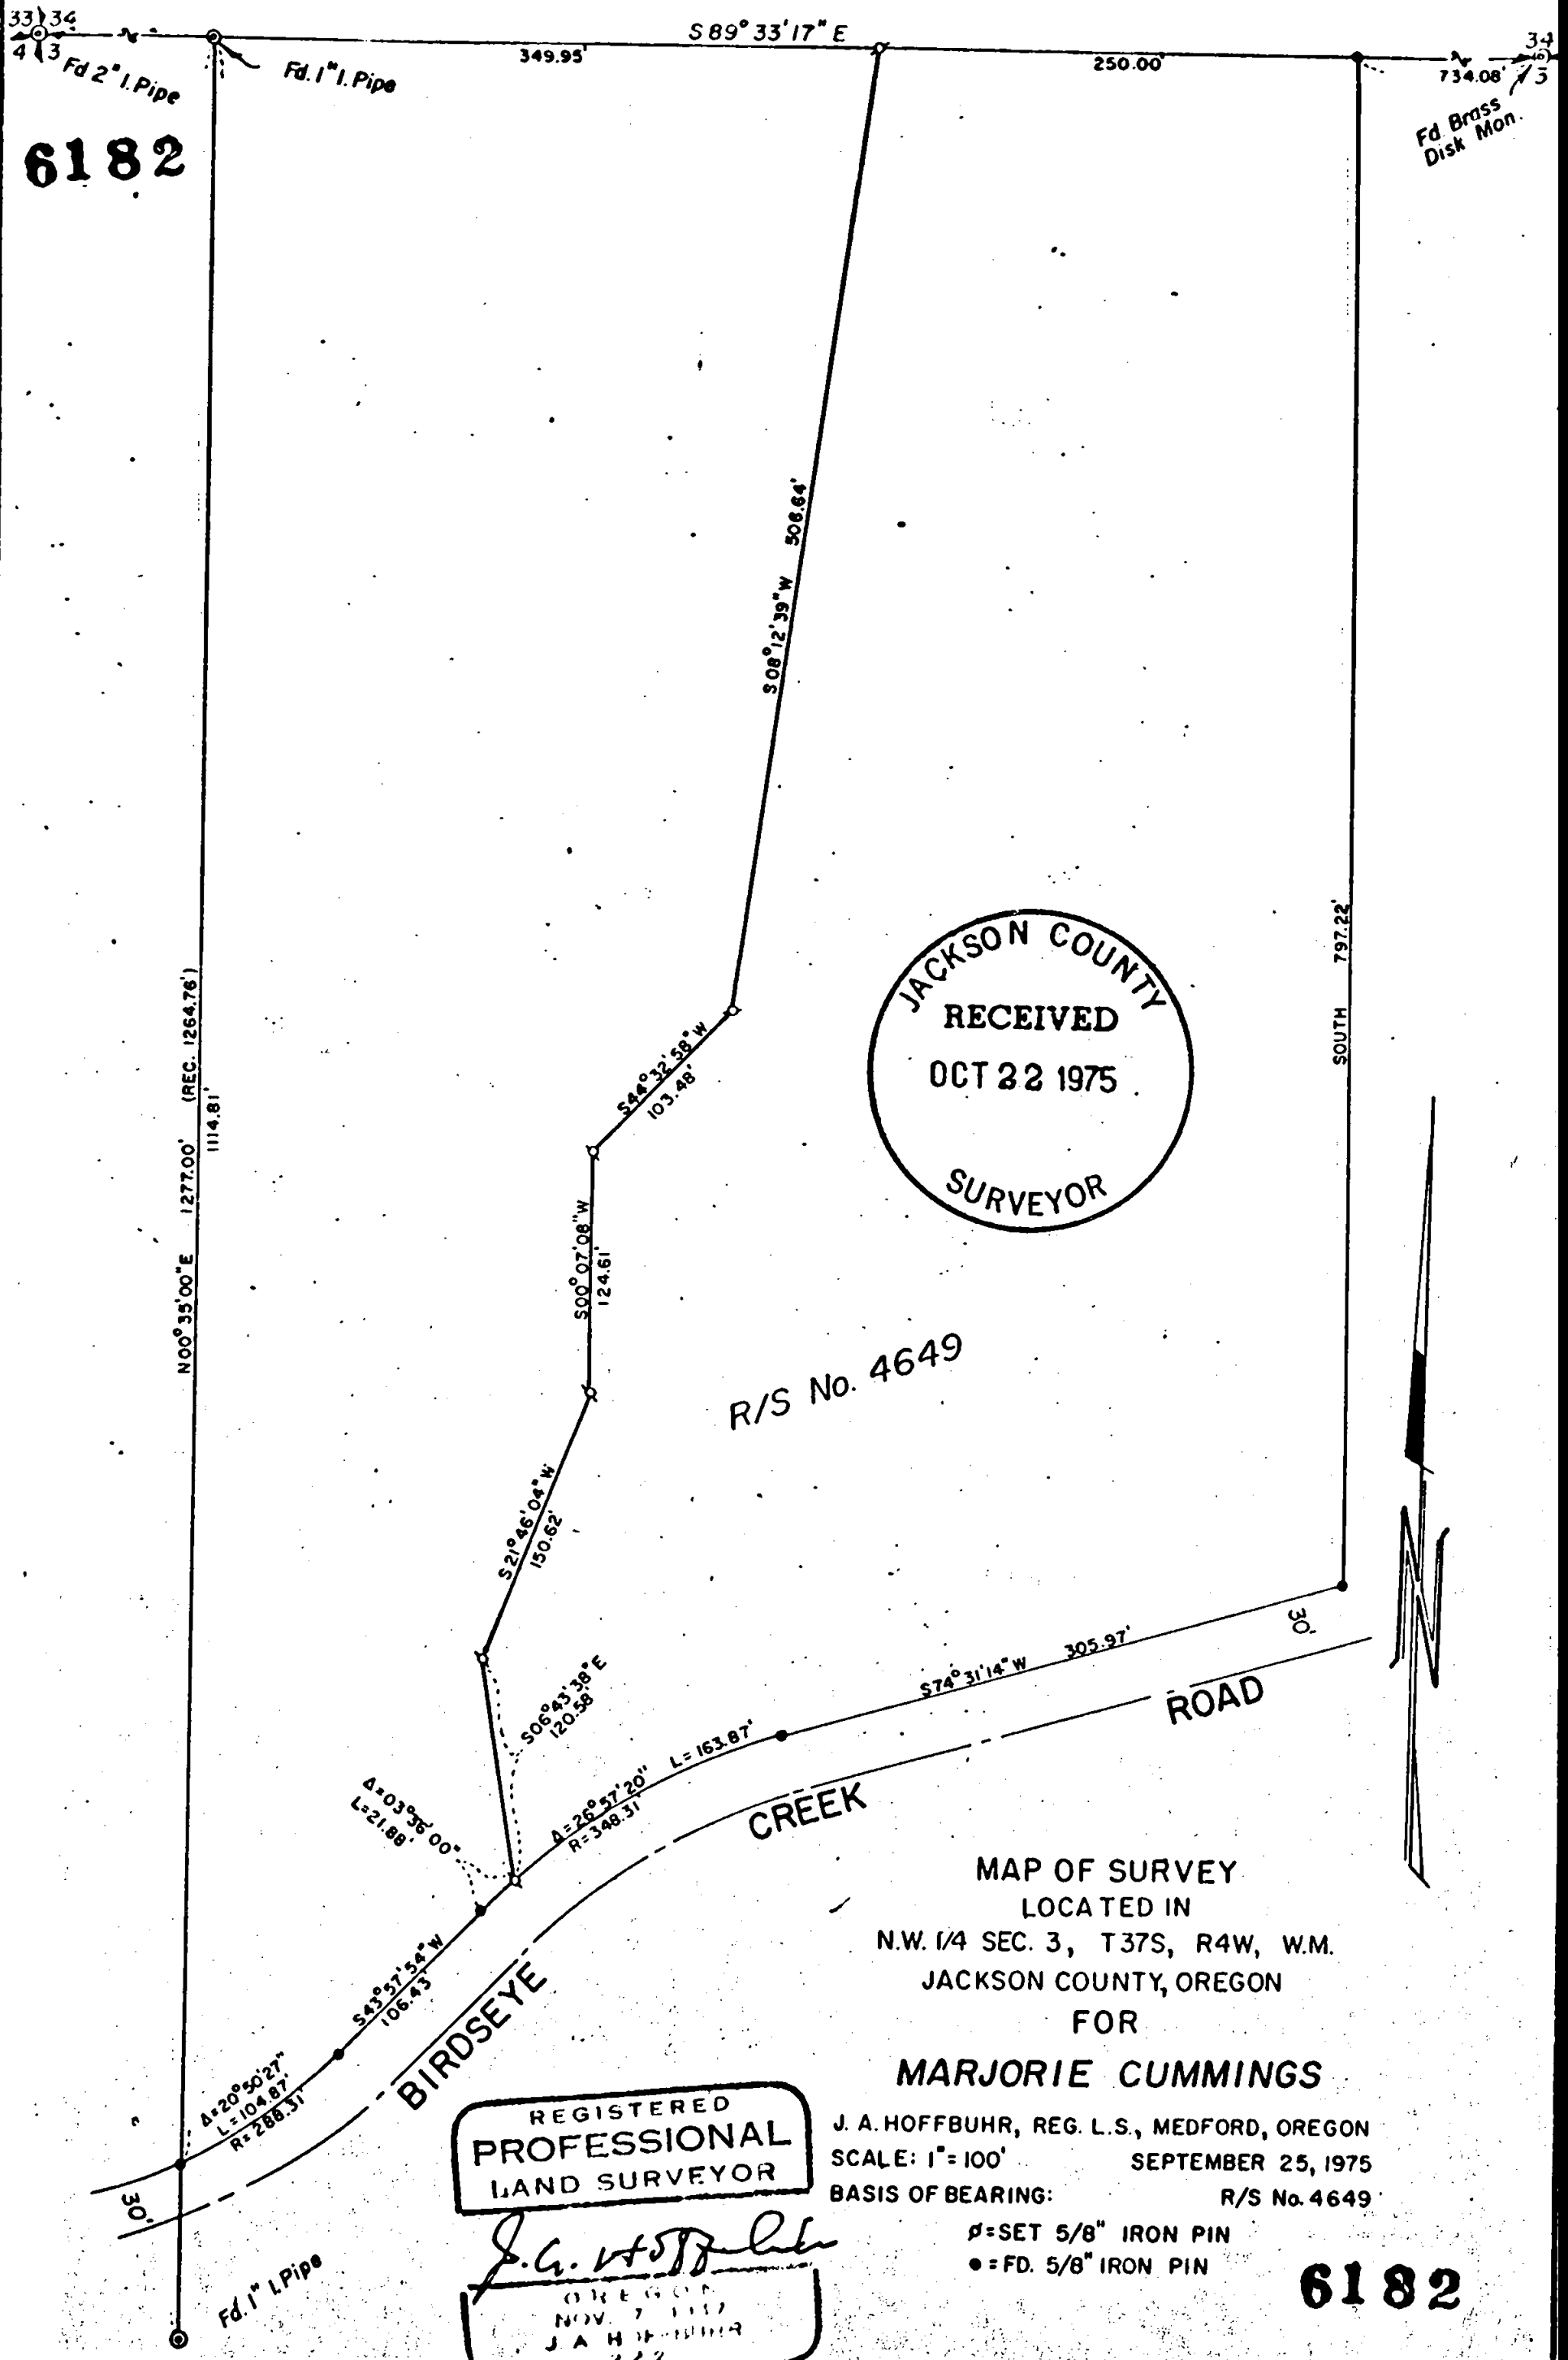

SURVEY NO. **6182**

SURVEY NARRATIVE TO COMPLY WITH PARAGRAPH 209.250
OREGON REVISED STATUTES



SURVEY FOR: Marjorie Cummings
123 N.E. Eveylyn
Grants Pass, Oregon 97526

LOCATION: Northwest one-quarter (1/4) of Section 3, Town-
ship 37 South, Range 4 West, Willamette Meridian,
Jackson County, Oregon


PURPOSE: To survey, monument, and describe the two parcels
as shown on the attached map as per client's re-
quest

PROCEDURE: Using control established by this office for
Recorded Survey No. 4649, set property corners as shown on the
attached map. Basis of bearing--Recorded Survey No. 4649.

September 25, 1975

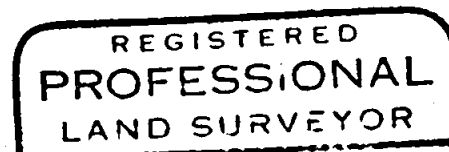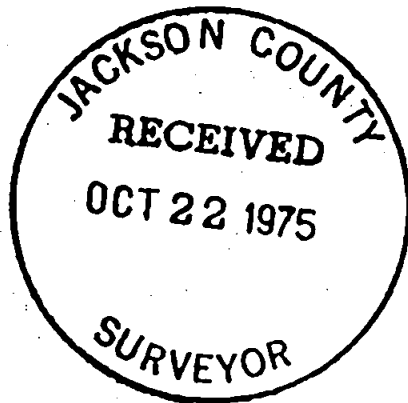

J. A. Hoffbuhr

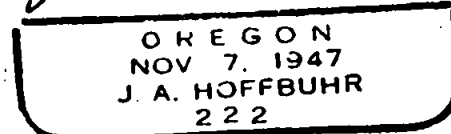

J. A. Hoffbuhr
Professional Land Surveyor

6182

53 T37 4W