6818.


MAP

SHOWING A SURVEY IN THE S.W. 1/4, N.W. 1/4
OF SEC. 30, T. 37 S., R. 4 W., W. M., JACKSON
COUNTY, OREGON
NOV. 13, 1975
SCALE: I" = 100'

SURVEYED FOR:

MR. EARL DOBLER % LEWIS REALTY 953 S.E. 7th ST. GRANTS PASS, OREGON SURVEYED BY:

MAX H. HULL SURVEYING 713 N. E. 7th ST. GRANTS PASS, OREGON

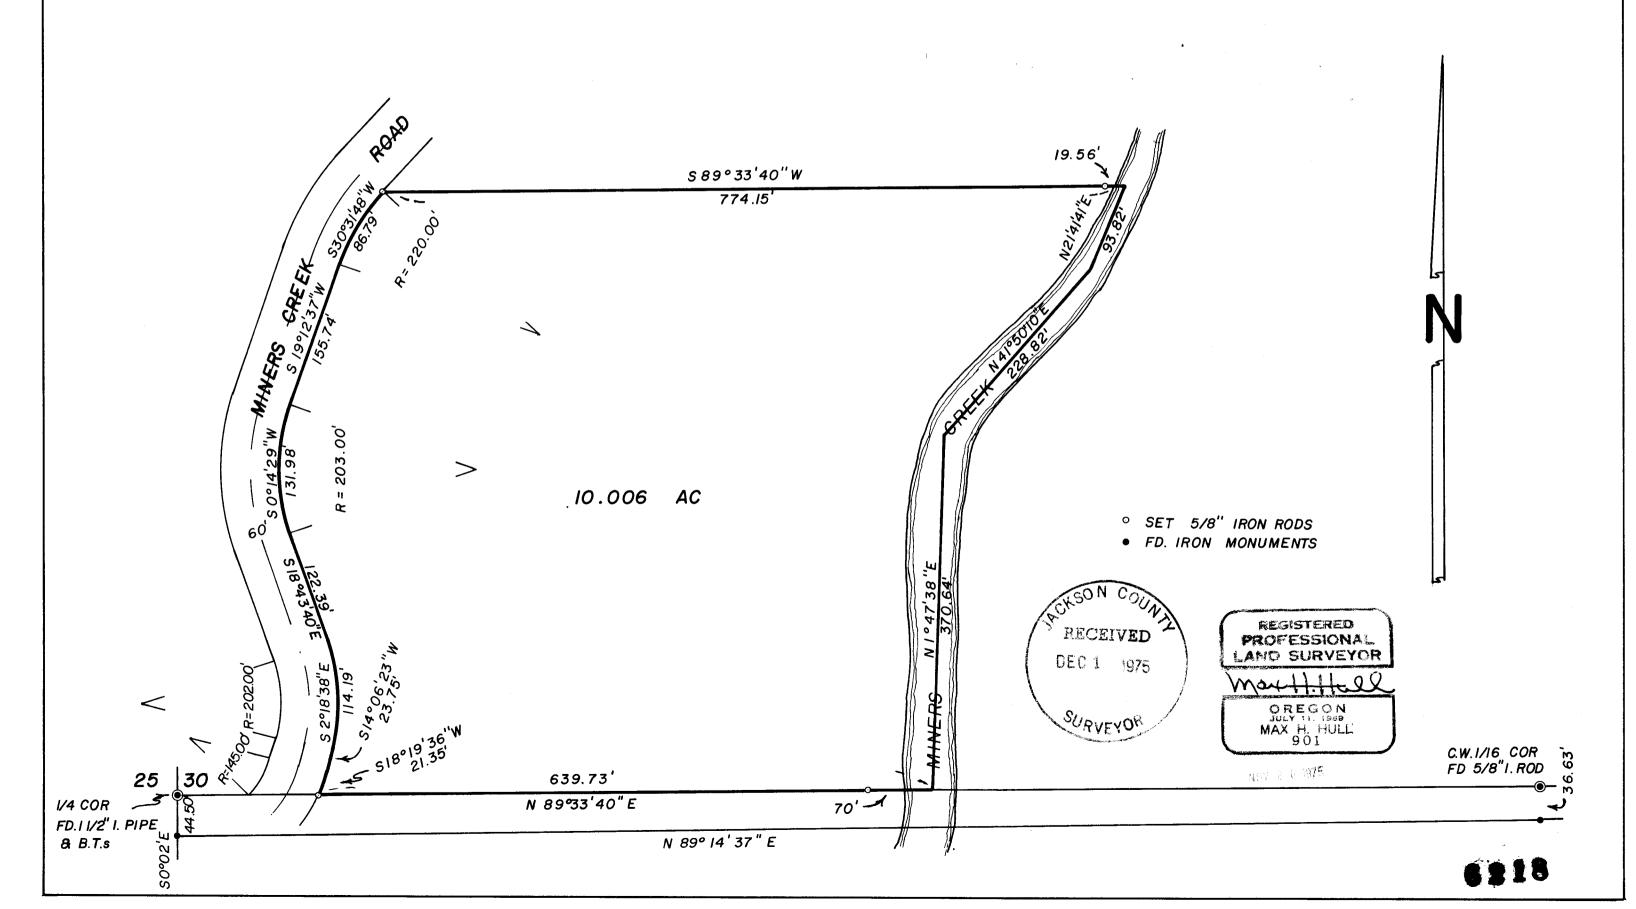





MAX H. HULL Land Surveying

713 N. E. 7th Street Grants Pass, Oregon 97526

SURVEY NARRATIVE to comply with Paragraph 209.250, O. R. S.

DATE:

November 13, 1975

FOR:

Mr. Earl Dobler c/o Lewis Realty 953 S.E. 7th Street Grants Pass, Oregon

PURPOSE:

To partition a 10 acre parcel of land in the Southwest 1/4 of the Northwest 1/4 of Section 30, Township 37 South, Range 4 West,

Willamette Meridian, Jackson County, Oregon.


PROCEDURE:

Starting at the West 1/4 of said Section 30 at which point I found A 1 1/2" Iron Pipe from which I found

A B. Oak 18 ins. diam South 38° East 36 Lks. A Fir 22 ins. diam. South 29° West 60 Lks. A Fir 14 ins. diam. North 86° West 69 Lks.

Thence I traversed to the Center West 1/16 corner of said Section 30 at which point I found a 5/8" Iron Rod per P.L.S. 301; thence I traversed the centerlines to Miners Creek and Miners Creek Road; thence I computed the acreage and set monuments as shown on the map.

Meridian is based on Josephine County Survey No. 137-68.

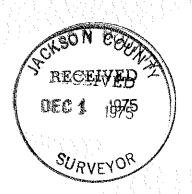

REGISTERED
PROFESSIONAL
LAND SURVEYOR

OREGON
MAX H. HULL
901