

6222

Initial Point of
Timber Line Subd.

TIMBER LINE SUBD

PONDEROSA DRIVE

TIMBERLINE TERRACE

R/S No. 4840

LOT 5

LOT 6

BLOCK 2

LOT 4

REC. N34°29'30" W
MEAS. N34° 36' 30" W
50.74
50.83

REC. 60.07
CALC. 54.07

LOT 9

LOT 10

WITNESS COR. 2.00'

LOT 11

N 33° 21' 00" E
90.00'

N 56° 39' 00" W
105.00'

N 33° 21' 00" E
90.00'

REC. 90.0
89.96'

LOT 4

BLOCK 3

LOT 3

LOT 2

N.E. COR.
LOT 12

JACKSON COUNTY
RECEIVED
DEC 16 1975
SURVEYOR

LOT 5
J. A. Hoffbuhr

REGISTERED
PROFESSIONAL
LAND SURVEYOR


OREGON
NOV 7 1947
J. A. HOFFBUHR

ALLAN ADAMS

MAP OF SURVEY
LOCATED IN
S.W. 1/4 OF SEC. 15, T39S, R1E, W.M.
JACKSON COUNTY, OREGON
FOR

J. A. HOFFBUHR, REG. L.S., MEDFORD, OREGON
SCALE: 1"=50'
BASIS OF BEARING - TIMBER LINE SUBD.
O = SET 5/8" IRON PIN
• = FD. 3/4" CRIMPED PIPE

6222

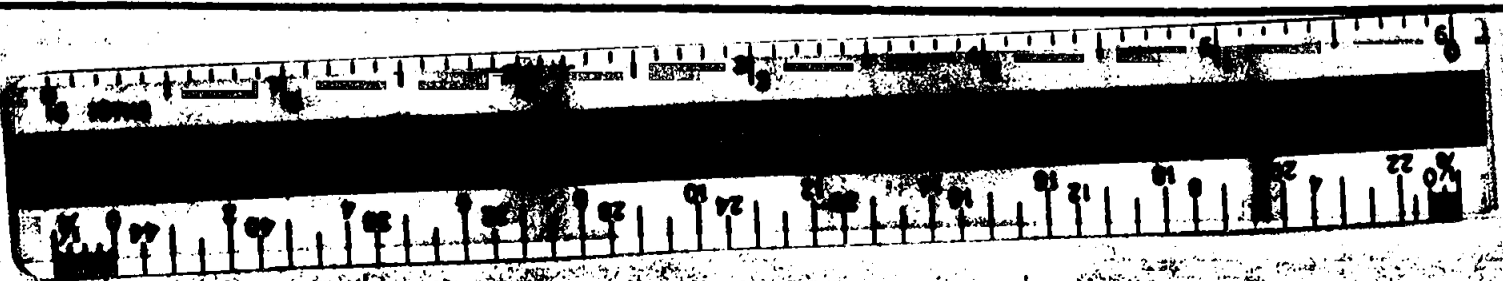

SURVEY NO. 6222

SURVEY NARRATIVE TO COMPLY WITH PARAGRAPH 209.250
OREGON REVISED STATUTES

SURVEY FOR: Allan Adams
1020 Timberline Terrace
Ashland, Oregon 97520



LOCATION: Southwest one-quarter (1/4) of Section 15,
Township 39 South, Range 1 East, Willamette
Meridian, Jackson County, Oregon

PURPOSE: To establish the property corners of Lot 10,
Block 3, of Timber line Subdivision

PROCEDURE: Located existing lot corners as shown on the
attached map and set the property corners of Lot 10 from the
existing control. No proportionate measurement was used for
this survey.

December 5, 1975

J. A. Hoffbuhr
Professional Land Surveyor

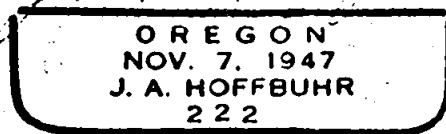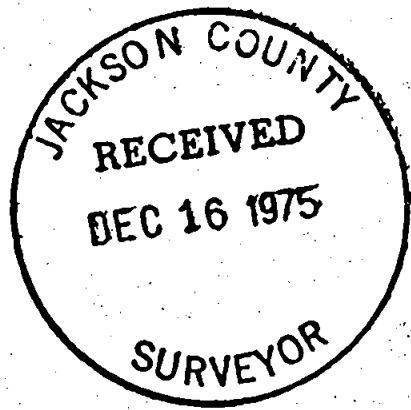

515 T 39 R1E