

6235

SURVEY FOR:

BOISE CASCADE CORP.

and

MEDFORD RESOURCES CORP.

LOCATED IN THE SOUTH-HALF OF SEC. 12,


T. 35 S. R. 1 E and SOUTH-HALF OF SEC. 7, T. 35 S. R. 2 E., WM.

BY: MARK E. BOYDEN

DEC. 18, 1975

T. 35 S. R. 1 E.
T. 35 S. R. 2 E.

SEC. COR. FD. BLM BR. CAP (1963)
EXP. 8"

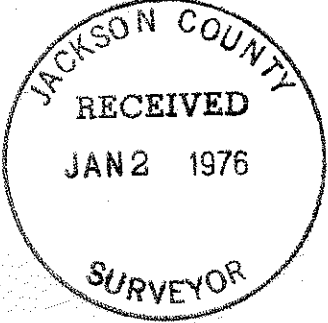

U.S.A.


1/4 COR.

N 0°02' 10" E

SCALE 1" = 500'
BASIS OF BEARINGS

MEAN OF 8 SOLAR OBSERVATIONS

● SET 3/4" x 36" G.I. PIPE WITH 2" BR. CAP EXP. 12"

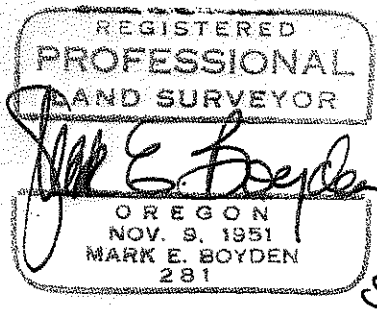

MEDFORD RESOURCES CORP.

S 1/16 COR.

1315.36'

1315.36'

U.S.A.

SEC. COR. FD. BLM BR. CAP (1967)
EXP. 5"

BOISE CASCADE CORP.

6235

6235

Survey No. 6235

FOR: Boise Cascade Corp. & Medford Resources Corp.

from which:

Scribed an 18" D. Fir, "1/4 S-BT" which bears S 48 1/2° E, 45.7 feet to the face of the lower blaze.

Scribed an 8" D. Fir, "1/4 S-BT" which bears S 41° W, 38.0 feet to the face of the lower blaze.

At the South One-Sixteenth corner common to Section 12, T35SR1E and Section 7, T35SR2E,

Set a 3/4" x 36" galvanized iron pipe, exposed 12", with 2" bronze cap stamped:

T 35 S

R1E		R2E
S12	+	S7

S 1/16 cor.
1975 ,



from which:

Scribed a 6" Black Oak "S 1/16 S7-BT" which bears S 80 1/4° E, 24.5 feet to the face of the lower blaze.

Scribed a 5" Fir, "S 1/16 S12-BT" which bears N 18° W, 13.6 feet to the face of the lower blaze.

Found a stone with cross, marked "1/16" on East side, set by Surveyor C. F. Rhodes in 1918, which bears S 38° W, 2.83 feet.

December 31, 1975

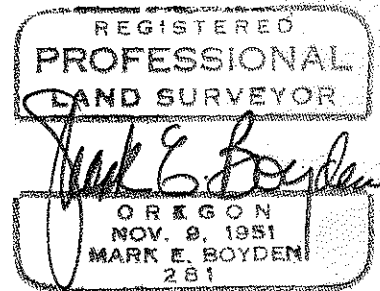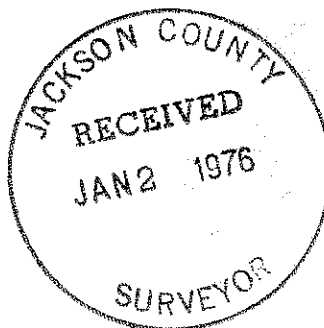

SURVEY NARRATIVE TO COMPLY WITH O.R.S. 209.250.

FOR: Boise Cascade Corp. & Medford Resources Corp.
 North Pacific Highway North Pacific Highway
 Medford, Oregon Medford, Oregon

- PURPOSE:
1. To monument and reference the Quarter corner common to Section 12, T35SR1E, W.M. and Section 7, T35SR2E, W.M.
 2. To monument and reference the South one-sixteenth Section corner common to said Sections 12 and 7.
 3. To tag, flag and blaze the East boundary of the Southeast 1/4 and the "East-West" centerline of said Section 12.

PROCEDURE: Utilizing a one second theodolite and an electronic measuring instrument, traversed between the Northeast and Southeast corners of said Section 12, said Section corners having previously been monumented from original corner evidences by the B.L.M.

No evidence of the original intervening Quarter corner could be found, said corner position being established by proportionate measurement on this survey. The South one-sixteenth corner was also established by proportionate measurement on this survey.

The position utilized for the Quarter corner common to Sections 11 and 12 was the stone with cross, set for corner by the County Surveyor in 1918 and further rehabilitated on Recorded Survey No. 4058.

The East boundary of the Southeast Quarter of Section 12 was run and marked on the true line.

The "East-West" centerline of Section 12 was chain-traversed, with offsets calculated from random hubs to true line.

At the Quarter corner common to Section 12, T35SR1E and Section 7, T35SR2E:

Set a 3/4" x 36" galvanized iron pipe, exposed 12", with a 2" bronze cap stamped:

T 35 S
 R1E | R2E
 S12 | S7
 1/4 cor.
 1975

