6279

BRIGGS SUBDIVISION UNIT NO. 3

TO THE CITY OF ASHLAND

LOCATED IN THE NW 1/4 OF SEC. 23, TWP. 39S., R.1E.W.M., JACKSON COUNTY, OREGON

76-02166

POST MONUMENTATION MAP

FEBRUARY 9, 1976

- ○ MONUMENTS PER ORIGINAL SUBDIVISION PLAT
- ● MONUMENTS PER ORIGINAL SUBDIVISION PLAT
- MONUMENTS PER ORIGINAL SUBDIVISION PLAT
- ◇ SET 5/8 x 24 INCH IRON PIN TAGGED RLS 759
- ◆ SET 5/8 x 30 INCH IRON PIN TAGGED RLS 759
- ◎ SET 1 INCH PIPE WITH BRONZE DISK IN MONUMENT CASE

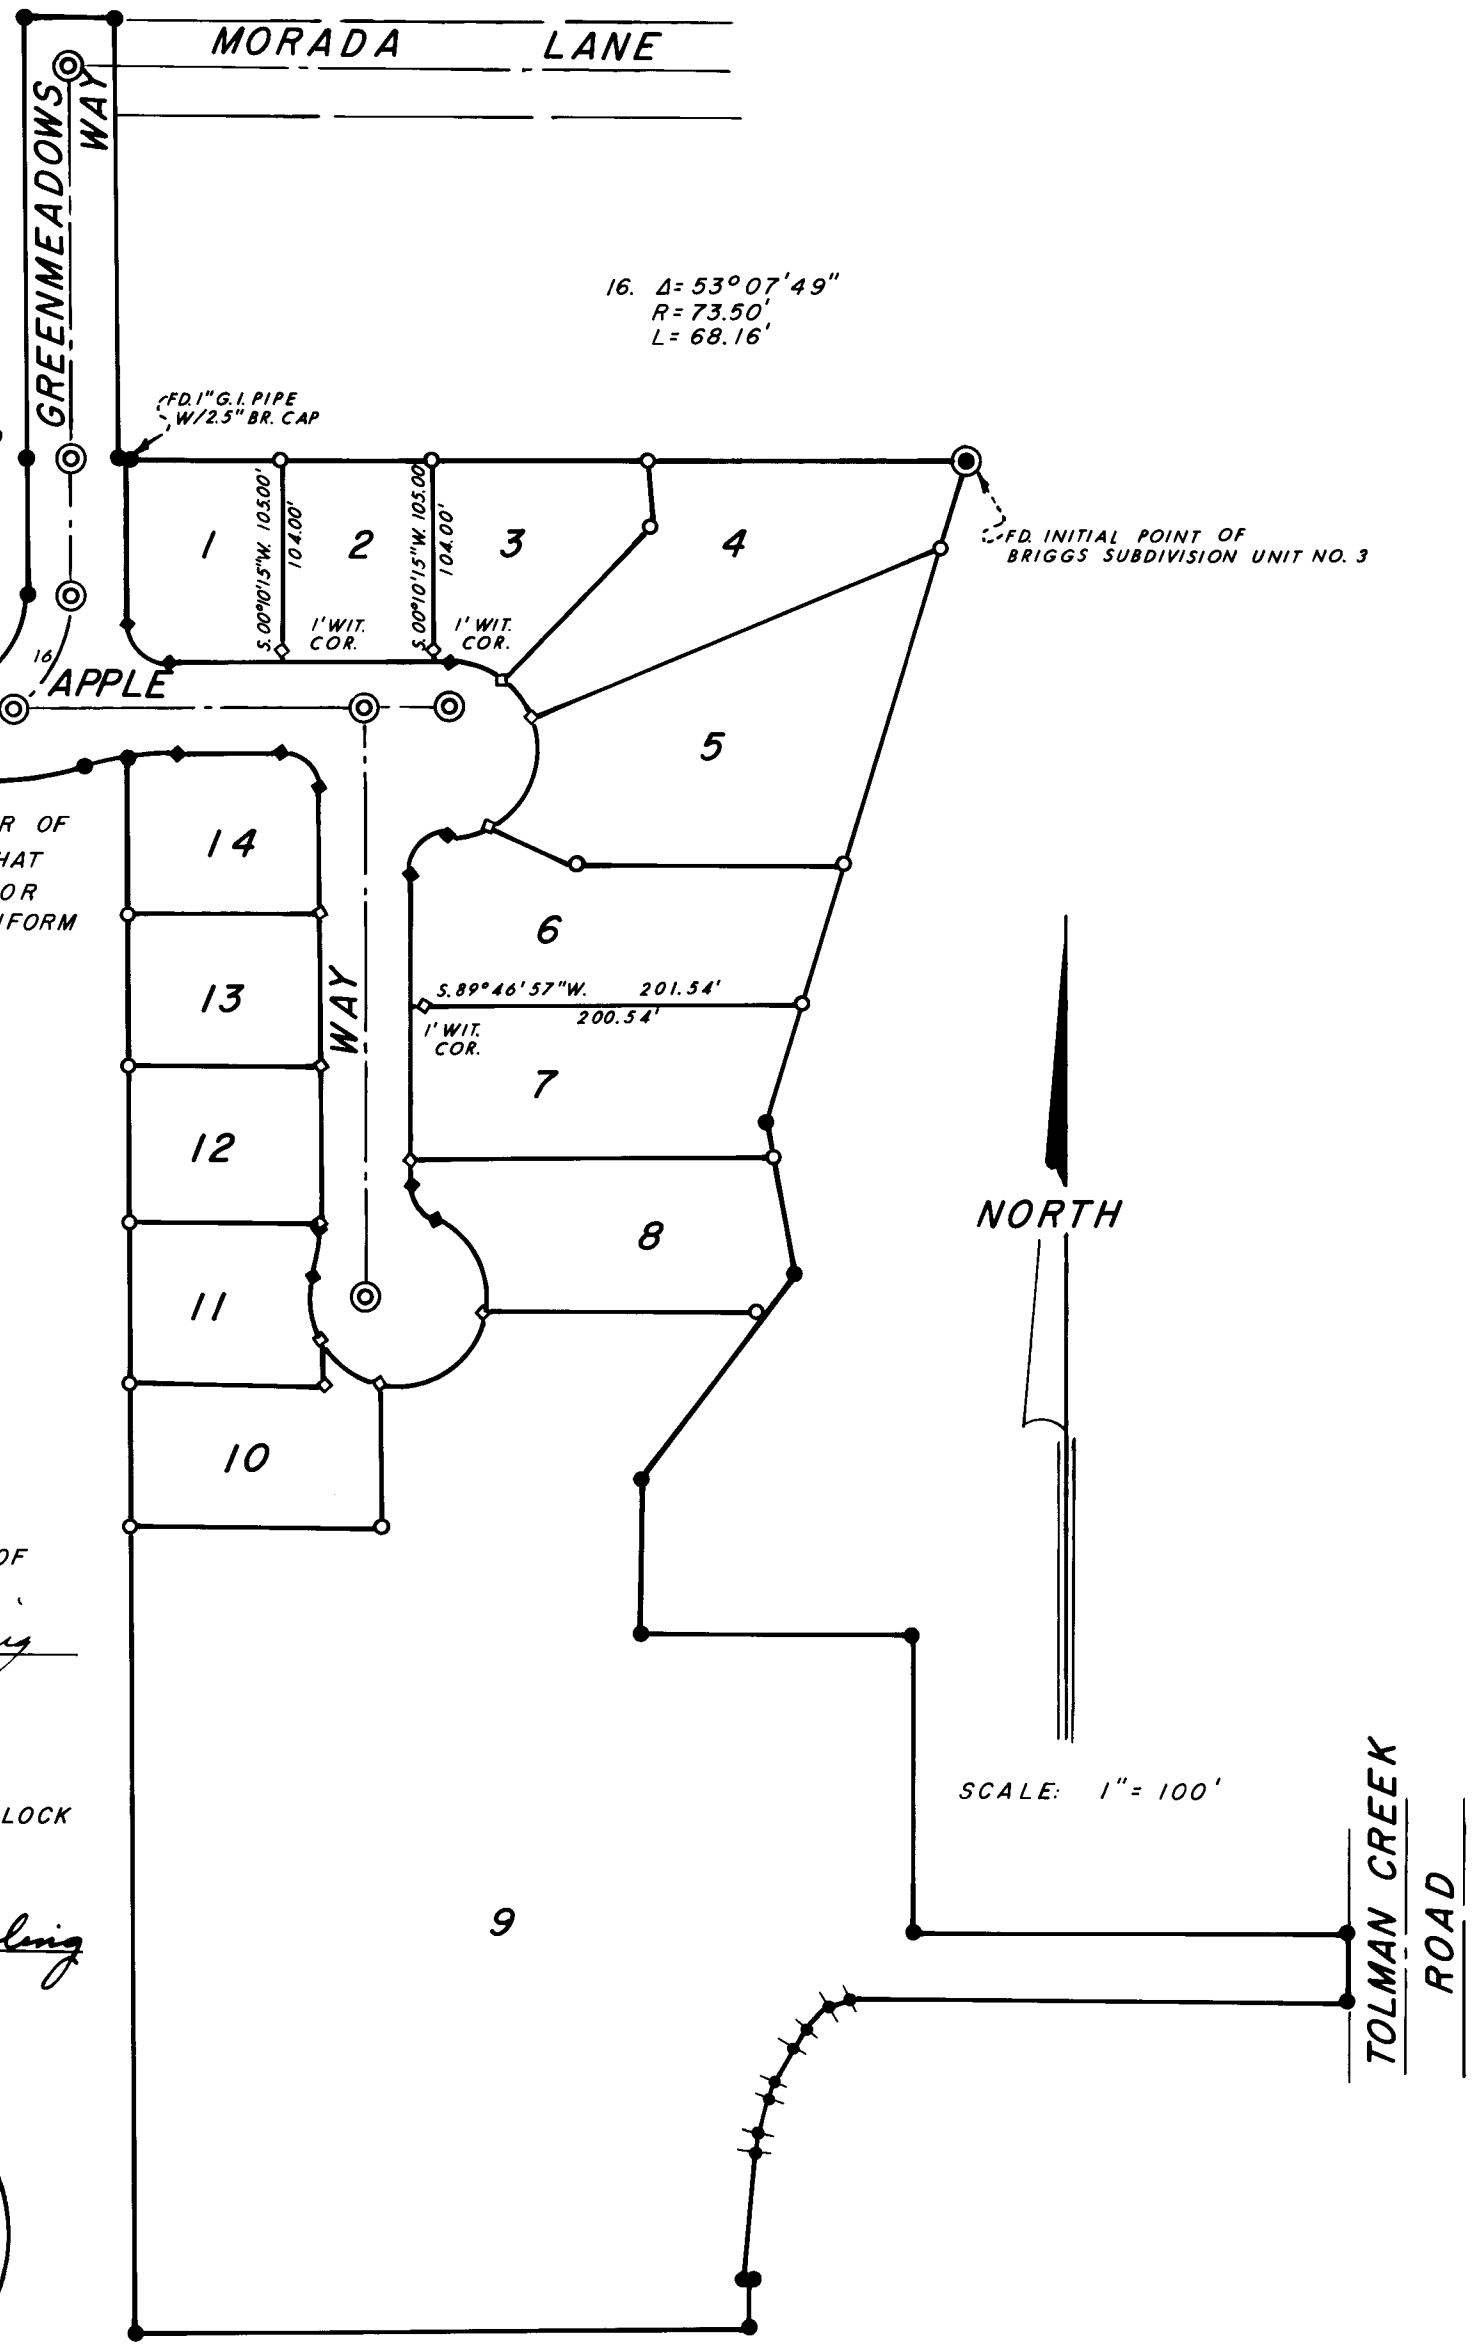

I, EVERETT L. SWAIN, DULY REGISTERED SURVEYOR OF THE STATE OF OREGON, DO HEREBY CERTIFY THAT THIS MAP REPRESENTS A SURVEY MADE BY ME OR UNDER MY DIRECTION AND THE MONUMENTS CONFORM TO O.R.S. 92.060

REGISTERED PROFESSIONAL LAND SURVEYOR
Everett L. Swain
OREGON
JULY 8, 1966
EVERETT L. SWAIN
759

EXAMINED AND APPROVED THIS 10th DAY OF February 1976

Allen A. Alsing
CITY ENGINEER

FILED FOR RECORD THIS 13th DAY OF February 1976 AT 10:43 O'CLOCK A. M. AND RECORDED IN THE OFFICIAL RECORDS OF JACKSON COUNTY, OREGON.

Harry Chipman COUNTY CLERK
Ruby A. Paling DEPUTY

JACKSON COUNTY RECEIVED FEB 13 1976 SURVEYOR

NOTE:

SEE PLAT OF BRIGGS SUBDIVISION UNIT NO. 3 FILED FOR RECORD THE 17TH DAY OF JUNE 1974 AT 11:06 O'CLOCK A.M. AND RECORDED IN VOLUME 12 OF PLATS AT PAGE 26 OF RECORDS OF JACKSON COUNTY, OREGON FOR LOT BEARINGS AND DISTANCES.

6279