

6296



Re: R/S No. 4686

R/W P.O.T. 25+00

N 00° 15' 50" E
657.24'

4 3
9 10

Section Corner
Fd. Brass Cap

642.18'

S 89° 46' 15" E 788.99'

S 07° 24' 50" E
186.64'

S 01° 44' 45" W
262.37'

S 18° 49' 50" W
218.81'

N 89° 58' 20" W
737.47' 984.37'

221.90' (REC 221.52)

R/W P.O.T. 9+00

FD. 5/8" IRON PIN
0.96' NORTH R/W LINE

HAMMEL ROAD

1/4 Sec. Cor.
Fd. Brass Cap

REGISTERED
PROFESSIONAL
LAND SURVEYOR
J. A. Hoffbuhr
OREGON
NOV. 7, 1947
J. A. HOFFBUHR
222

MAP OF SURVEY
LOCATED IN
N.W. 1/4 of Sec. 10, T35S, R1W, W.M.
JACKSON COUNTY, OREGON
FOR
CLINTON AYRES

J. A. HOFFBUHR, REG. L.S., MEDFORD, OREGON
SCALE: 1"=100' FEBRUARY 28, 1976
BASIS OF BEARING- R/S No. 4686
⊕=SET 5/8" IRON PIN
●=FD. 5/8" IRON PIN

R/S No. 3416

6296

SURVEY NARRATIVE TO COMPLY WITH PARAGRAPH 209.250
OREGON REVISED STATUTES



SURVEY FOR: Clinton Ayres
214 Hammel Road
Eagle Point, Oregon 97524

LOCATION: Northwest one-quarter (1/4) of Section 10,
Township 35 South, Range 1 West, Willamette
Meridian, Jackson County, Oregon

PURPOSE: To survey, monument, and describe the tract as
shown on the attached map as per client's request

PROCEDURE: Located and tied the Northwest corner and the West
one-quarter (1/4) corner of Section 10 as shown. Located the North
right of way line of Hammel Road as per County right of way monu-
ments. The North and East boundaries of the subject tract were
monumented as per client's request. Basis of bearing--Recorded
Survey No. 46.86.

March 1, 1976

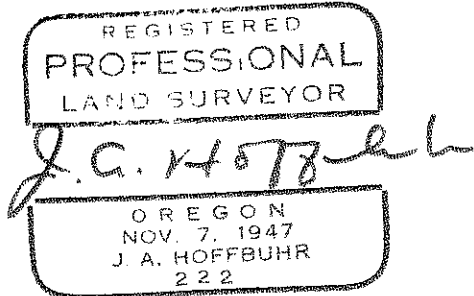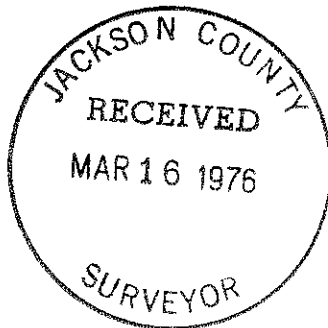

J. A. Hoffbuhr
Professional Land Surveyor