

SURVEY NARRATIVE TO COMPLY WITH PARAGRAPH 209.250 OREGON REVISED STATUTES

Floyd W. Fogelquist Survey for:

44 Dunlap Road

Jacksonville, Oregon 97530

Survey by : Charles H. Hurst, L.S.

304 South Holly Street Medford, Oregon 97501

Bearing Based on the meridian for Record Survey No. 2640

Purpose To monument the corners and define the boundaries

of the tracts shown.

PROCEDURE

Section line control was run in the latter part of 1971 utilizing EDM equipment and the proportionate W 1/16 and 1/4 corners were set at that time. Since the client was also interested in the location of the SE corner of Gov't. Lot 8, an extensive field investigation was launched for the recovery of additional DLC corners so that the westerly boundary of DLC 41 could be determined. This investigation was conducted preiodically, as time permitted, over a period of several years without success.

Upon request for additional work, as shown on the attached plat, data relative to the section line as monumented in 1971 on the basis of an open traverse, was verified by a closing loop and held as originally monumented

In view of substantial discrepancies found to exist by comparison of the official record for the original government survey of Section 33 and that for DLC 41, it was determined that only by approximation could the SE corner of Government Lot 8 be established at this time. Accordingly, the record dimension of 396 feet was held and a witness corner was set in lieu thereof. The northeast corner of the 7.801 acre tract was also set as a closing corner and the client is advised that said witness corners were set for East - West line control only


Witness trees were taken and measured to center as follows:

A White oak, 18.7" dia., S 69°05' W 257.13 feet dist.. 1/4 33/4 mkd. 1/4 S4 BT

W 1/16 33/4 A Black oak, 11.5" dia., N 86° 04' E 44.33 feet dist., mkd. W 1/16 S33 BT

> A White oak, 22.5" dia., S 88°54' W 40.71 feet dist., mkd. W 1/16 S4 BT

February 26, 1976

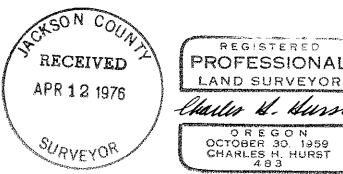

LAND SURVEYOR Charles W. Gurst OREGON OCTOBER 30. 1959 CHARLES H. HURST 483