

SURVEY PLAT AND NARRATIVE TO COMPLY WITH PARAGRAPH 209.250, OREGON REVISED STATUTES

Survey for: Harry Nugent
6226 E. Evans Creek Rd.
Rogue River, Oregon 97537

Survey by: Charles H. Hurst
304 S. Holly
Medford, Oregon 97501

Bearing: Plat record for the east boundary of Lot 17


Purpose: To define the boundary and monument the corners of O.R. 72-07997.

SURVEY SITUATE IN LOT 17 OF PLEASANT VALLEY FARM TRACTS (S½NW¼ SECTION 22), T. 35 S. R. 4 W., W.M., JACKSON COUNTY, OREGON.

SCALE: 1" = 200'

LEGEND

- Set 5/8" x 24" iron pins
- Found 1/2" iron pipe lot corners

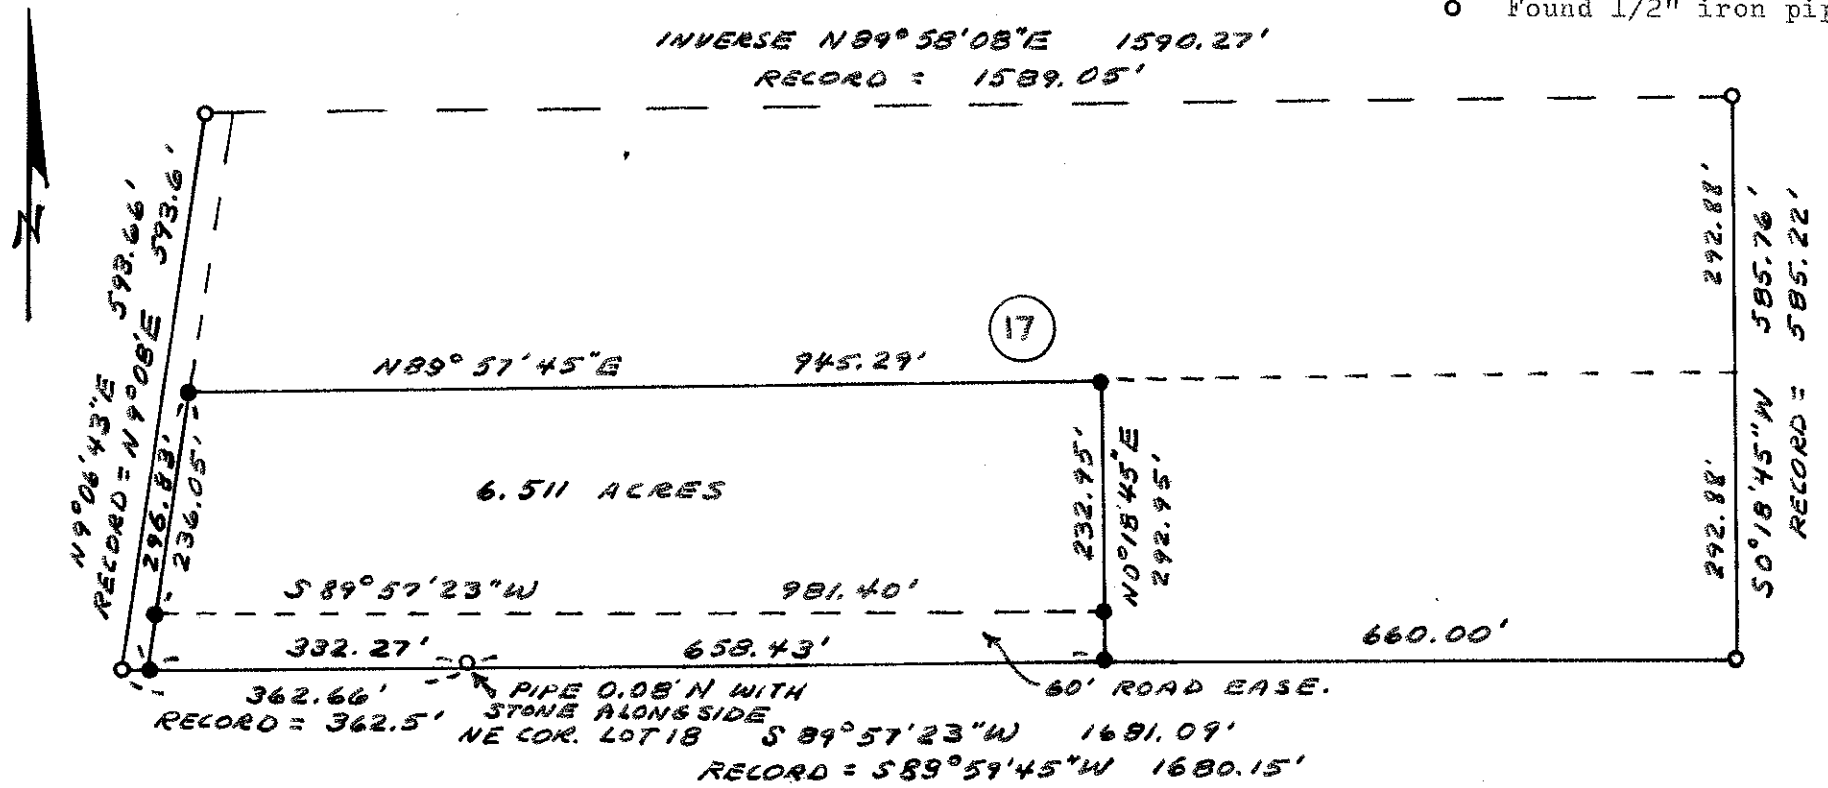

REGISTERED
PROFESSIONAL
LAND SURVEYOR

Charles H. Hurst

OREGON
OCTOBER 30, 1959
CHARLES H. HURST
483

JAN 23 1976

JACKSON COUNTY
RECEIVED
APR 12 1976
SURVEYOR







