

6334

DIETZGEN

E.N.E. COR. D.L.C. NO. 42
FD. BRASS DISK IN
MONUMENT CASE

FD. 5/8" PIN
S.0.02' & E. 0.31'

S 89° 59' 50" E
80.00'

N 00° 05' 00" E 100.00'

FD. 3/4" PIPE
N. 0.18' & E. 0.10'

FD. 3/4" PIPE
N. 0.15' & E. 0.22'

FD. 5/8" PIN
S. 0.07' & E. 0.25'

S 89° 59' 50" E
50.00'

FD. 5/8" PIN
N. 0.00' & E. 0.18'



SURVEY NO 5811

SURVEY NO 2800

● = FOUND MONUMENT AS SHOWN
○ = SET 5/8" PIN WITH YELLOW
PLASTIC CAP, NO. 961
BASIS OF BEARINGS: SURVEY NO. 5811

N 00° 05' 00" E
CRATER LAKE AVENUE

FD. 1/2" PIPE
S. 0.32' & W. 0.71'

FD. 5/8" PIN
S. 0.44' & W. 0.50'

FD. 5/8" PIN

30.00'

130.00'

N 00° 05' 00" E 261.87'

S 00° 05' 00" W 361.87'

S.E. COR. D.L.C. NO. 42
FD. 5/8" PIN IN
MONUMENT CASE

EAST MAIN ST.

S 89° 59' 50" E

N.E. COR. D.L.C. NO. 44


PLAT OF SURVEY
FOR

LAVENE KONSCHOTT-PICKETT

BEING A PORTION OF THE N.E. 1/4
OF SECTION 30, T37S, R.1W., W.M.
JACKSON CO. SCALE: 1"=50'
OREGON DATE: FEB, 1976

PREPARED BY: FRIAR - MOFFIT SURVEYING
MEDFORD, OREGON

REGISTERED
PROFESSIONAL
LAND SURVEYOR

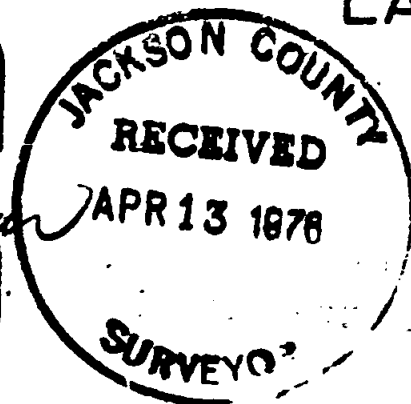

CREG GOR
JULY 16, 1971
LARRY J. FRIAR
961

6334

SURVEY NO. 6334

SURVEY NARRATIVE TO COMPLY WITH O.R.S. 209.250

FOR: Lavene Konschott-Pickett
3952 S. Ridge Dr.
Eugene, Oregon 97405


LOCATION: Located in the N.E. $\frac{1}{4}$ of Section 30,
Township 37 South, Range 1 West,
Willamette Meridian, Jackson County,
Oregon.

PURPOSE: To monument and describe the parcel
shown on the attached map.

PROCEDURE: Using control established by this
office in the execution of field
survey No. 5811, the parcel was
laid out and monumented as shown
on the attached map.

DATE: February, 1976

Larry J. Friar
Professional Land Surveyor

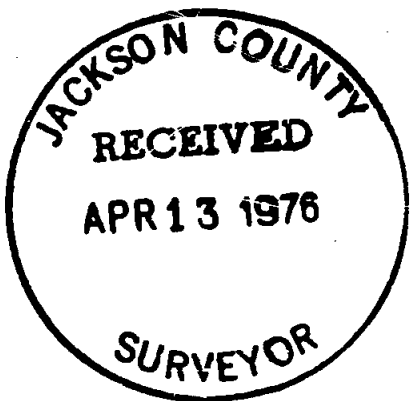

6334

S30 T37 IW