


**AIRPORT VICINITY  
GOVERNMENT CORNER TIES**

JACKSON COUNTY SURVEYOR'S OFFICE  
PROJECT NO. 76-1

ALL BEARINGS AND DISTANCES SHOWN HEREON ARE GRID,  
BASED ON THE PUBLISHED USCGS COORDINATES OF  
STATIONS BEACON AND COKER 1969 ADJUSTMENT.

ALL MONUMENTS FOUND OR SET AS SHOWN  
SCALE: 1" = 500'  
DATE: APRIL 1, 1976  
LOCATION: TWPS. 36 and 37 SOUTH, RNGS. 1 and 2 WEST, W.M.  
COMBINED FACTOR = 0.9999267308

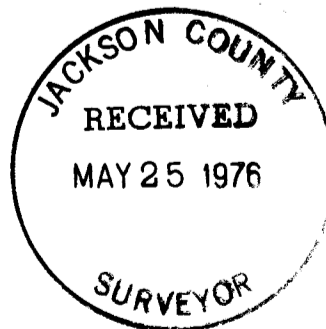

## SURVEY NARRATIVE TO COMPLY WITH O.R.S. 209.250

SURVEY FOR: Jackson County

SURVEY BY: Jackson County Surveyor's Office. Ref.: Job. No. 76-1.

DATE: April 1, 1976

LOCATION: Sections 6, 5, 7 and 18, Township 37 South, Range 1 West of the Willamette Meridian, Jackson County, Oregon.

PROCEDURE: This survey was conducted in order to establish Oregon State Plane Co-ordinates on those Government corners shown on the accompanying map. This was done to secure the relative positions of said corners and to provide control for future projects in and around the airport area.

The basis of bearing and co-ordinates was obtained from published U.S.C. and G.S. data of triangulation stations Beacon and Coker, 1969 Adjustment.

All angular measurements were made with a 1 second theodolite and distances were measured electronically.

All field notes, computations and co-ordinates are on file in the Jackson County Surveyor's office under Job No. 76-1 and Job No. 75-16.

