

6377

C. 1/4 COR
FD. 5/8" I. ROD

N 89°31'26" W
1321.94'

C.E. 1/16 COR
FD. 5/8" I. ROD

660.97'

660.97'

FD. 5/8" I. ROD
WEST 1.04'

669.04'

668.79'

N 0°17'31" E

668.54'

S 0°23'00" W
1338.08'

662.11'

25.00'

662.11'

1337.08
N 0°11'47" E

1324.22'
N 89°32'48" W

669.04'

668.54'

S.E. 1/16 COR.
FD. 5/8" I. ROD

663.20'

663.20'

1326.40'
S 89°34'08" E


C.S. 1/16 COR.
RESET 5/8" I. ROD

○ SET 5/8" x30" IRON ROD

MAP

SHOWING A SURVEY IN THE NW. 1/4, S.E. 1/4
OF SEC. 36, T. 37 S., R. 3 W., W.M., JACKSON
COUNTY, OREGON
MAY 28, 1976

SCALE: 1" = 200'

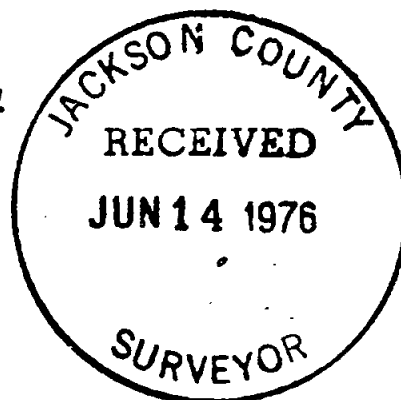

SURVEYED FOR:

ROGUE VALLEY TREES INC.
620 S.W. 4th ST.
GRANTS PASS, OREGON


SURVEYED BY:

MAX H. HULL SURVEYING
713 N.E. 7th ST.
GRANTS PASS, OREGON

REGISTERED
PROFESSIONAL
LAND SURVEYOR

Max H. Hull
OREGON
JULY 11, 1969
MAX H. HULL
901

6377

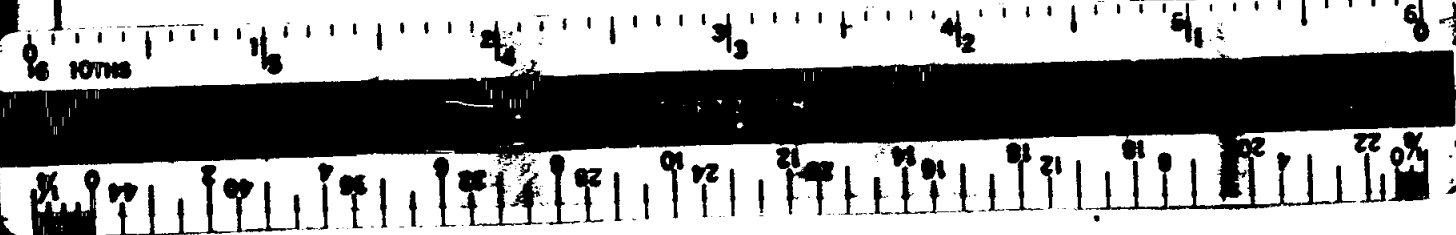

6377

Office 476-2425



MAX H. HULL Land Surveying

713 N. E. 7th Street Grants Pass, Oregon 97526

SURVEY NARRATIVE to comply with Paragraph 209.250, O. R. S.


DATE: May 28, 1976

FOR: Rogue Valley Trees Inc.
620 S.W. 4th Street
Grants Pass, Oregon

PURPOSE: To partition into three parcels, the Northwest 1/4 of the Southeast 1/4 of Section 36, Township 37 South, Range 3 West, Willamette Meridian, Jackson County, Oregon.

PROCEDURE: Starting at the center 1/4 corner at which point I found a 5/8" Iron Rod per survey 3359; thence I surveyed South 0°23'00" West 1338.08 feet and reset a 5/8" Iron Rod at a point determined from survey no. 2493; thence I surveyed South 89°34'08" East 1326.40 feet to a 5/8" Iron Rod per survey 2493; thence I surveyed North 0°11'47" East 1337.08 feet to a 5/8" Iron Rod per survey 3324; thence I surveyed North 89°31'26" West (this bearing is shown as South 89°29'55" East per surveys 2493 and 3359, but is shown as North 89°29'55" East per survey 3324) 1321.94 feet back to the center 1/4; thence I computed new corner locations, set monuments and surveyed partition lines as shown on the map.

Meridian is based on survey no. 2493.

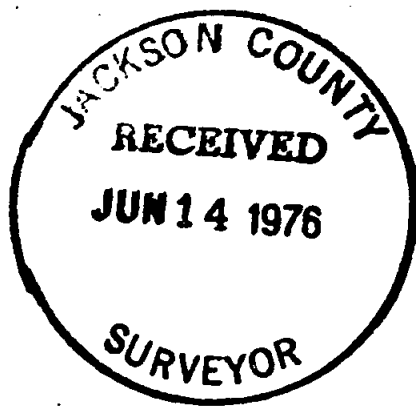

S36 37 3W