

FD. 1/2" IRON PIPE

R/S No. 4326

J.C. Inst. No. 75-13606

J.C. Inst. No. 75-11936

S.W. Cor. D.L.C. No. 78  
FD. BRASS CAP

S.E. Cor. D.L.C. No. 78  
FD. BRASS CAP

MAP OF SURVEY  
LOCATED IN  
N.W. 1/4 of Sec. 34, T37S, R2W, W.M.  
JACKSON COUNTY, OREGON  
FOR  
**LAVONA MANUEL**

J. A. HOFFBUHR, REG. L.S., MEDFORD, OREGON  
SCALE: 1" = 100'  
JUNE 16, 1976  
BASIS OF BEARING - R/S No. 4326

- = SET 5/8" IRON PIN
- = FD. 5/8" IRON PIN

REGISTERED  
PROFESSIONAL  
LAND SURVEYOR

J. A. Hoffbuhr  
OREGON  
NOV. 7, 1947  
J. A. HOFFBUHR  
222

BELLINGER

LANE

SURVEY NO. 6393

SURVEY NARRATIVE TO COMPLY WITH PARAGRAPH 209.250  
OREGON REVISED STATUTES



SURVEY FOR: LaVona Manuel  
3378 Bellinger Lane  
Medford, Oregon 97501

LOCATION: Northwest one-quarter (1/4) of Section 34,  
Township 37 South, Range 2 West, Willamette  
Meridian, Jackson County, Oregon

PURPOSE: To survey, monument, and redescribe the tracts  
as shown on the attached map as per client's  
request

PROCEDURE: Using control established by Recorded Survey  
No. 145 and Recorded Survey No. 4326, located the boundaries of  
three previously described tracts. The location of Griffin Creek  
and two access roads were used to determine the segregation line  
between the described tracts as per client's request. Basis of  
bearing--Recorded Survey No. 4326.

June 21, 1976

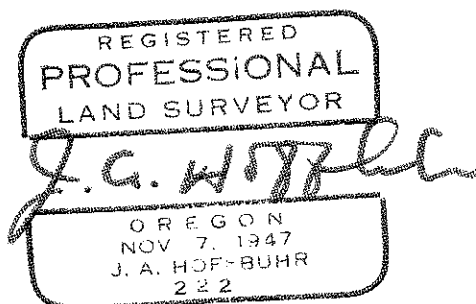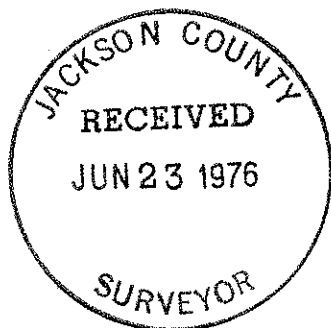

J. A. Hoffbuhr  
Professional Land Surveyor