

NOTES:

- MONUMENTS FOUND AS SHOWN.
- SET 5/8" REBAR WITH RED CAP MARKED "RILEY RS 705"
- BEARINGS ARE REFERENCED TO SURVEY NO. 1473.


SURVEY OF PROPERTY LOCATED IN THE NW 1/4 OF SEC. 22, T. 36 S., R. 4 W., W.M., JACKSON CO., ORE.

SURVEYED FOR:

SOUTHERN OREGON FEDERAL CREDIT UNION,
1670 WILLIAMS HWY.,
G. P., ORE.

SURVEYED BY:

GERALD D. RILEY, R.S. 705,
731 N.E. 7th STREET,
GRANTS PASS, ORE.

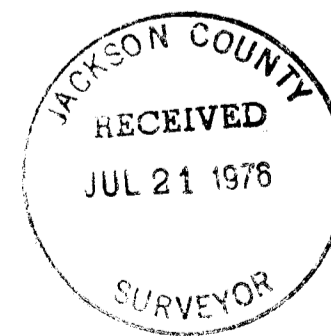

SCALE: 1" = 100'

DATE: JUNE 21, 1976.

REGISTERED
PROFESSIONAL
LAND SURVEYOR

Gerald D. Riley
OREGON
JULY 9, 1968
GERALD D. RILEY
705

SURVEY NO. 6412

SURVEY NARRATIVE to comply with the Paragraph 209.250,
Oregon Revised Statutes.

Survey For: Southern Oregon Federal Credit Union
1670 Williams Hwy.
Grants Pass, Oregon 97526

PURPOSE: To locate and monument that property being
purchased by Southern Oregon Federal Credit
Union, in the North West $\frac{1}{4}$ of Section 22,
Township 36S., Range 4 West, W.M., Jackson
County Oregon.

PROCEDURE: I began at the Northwest corner of the section
and traversed Easterly to the North $\frac{1}{4}$ corner as
shown. I then compute the true location of the
 $\frac{1}{16}$ corner and traversed Southerly and Westerly
to the property to be surveyed, per the deed
descriptions and run the lines and set the cor-
ners as shown.

