

6417

FD. 1/2" I. PIN



FD. 1/4" I. PIPE (A) 9.96' = 3.036 M  
S. 1° 01' 35" E. 18.93' = 5.77 M (C)  
(B) SET 1" I. PIPE 0.05' = 0.015 M

SURVEY NO. 1721  
SUR. NO. 1721 = 94.820 M  
N. 0° 07' E. 311.09'  
N. 0° 06' W.

26 25  
\* \* \* \* \* FD. 2" I. PIPE  
35 36


REGISTERED  
PROFESSIONAL  
LAND SURVEYOR

*Edward A. McGinty*

OREGON  
JULY 10, 1953  
EDWARD A. MCGINTY  
301

DEPENDENT SURVEY IN SE 1/4 SEC. 26, T. 36 S., R. 2 W., W.M.  
FOR  
BEAR CREEK VALLEY SANITARY AUTHORITY  
(76-21)

BY EDWARD MCGINTY  
MEDFORD, OREGON

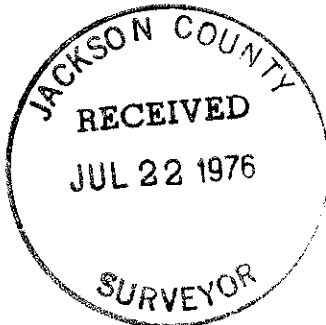

SCALE 1" = 10'  
JUNE 1976  
M = METER

6417

6417

6417

6417

SURVEY NO. \_\_\_\_\_

SURVEY NARRATIVE TO COMPLY WITH O.R.S. 209-250

76-21

Survey for: Bear Creek Valley Sanitary Authority  
3915 South Pacific Hwy.  
Medford, Oregon 97501

Survey by: Edward A. McGinty, R.S.  
Medford, Oregon  
June, 1976

Location: SE. 1/4 of Sec. 26, T36S, R2W.

Basis of Bearing: Survey No. 4909

Precedence of Survey:

During recent construction of sewer line lateral a 1 in. iron pipe, shown on survey No. 1720 as the NE. corner of a 2.35 Acre tract and also shown on survey No. 1721, was removed during construction.

The request was to reset or replace corner in its previous location.

This was done by utilizing previous survey data acquired on Survey No. 4909 and resetting the original monument, being a 1 in. pipe, 21 ins. long as a witness corner 0.05 ft. east of its original position as it existed Feb. 1972 (point No. B)

Pt. C a traverse station on survey No. 4909 (1/2 in. iron pin) which was previously used in a side tie to point B, was used ~~by~~ to determine its previous location.

According to preliminary check north to Gibbon Rd. indicates this point may not be on the section line as established.

