

6437

6437

15 14  
22 23  
FD. CO. SURVEYOR'S  
RE-ESTAB. CORNER



2643.76'  
1321.88'

NORTH  
1321.88'

1/16 CORNER  
SET 5/8" IRON PIN

22 23  
1/4 COR. FD. CO. SURVEYOR'S  
RE-ESTAB. CORNER

REGISTERED  
PROFESSIONAL  
LAND SURVEYOR  
*Larry J. Friar*  
OREGON  
JULY 16, 1971  
LARRY J. FRIAR  
981

JACKSON COUNTY  
RECEIVED  
AUG 12 1976  
SURVEYOR

PLAT OF SURVEY  
FOR  
ROBERT JENKINS

LOCATED IN THE N.E. 1/4, SECTION  
22, T. 38 S., R. 1 E., W.M.  
JACKSON CO. OREGON  
SCALE: 1"=300' JULY, 1976

BASIS OF BEARING: GOV'T. RECORD  
PREPARED BY: FRIAR-MOFFIT SURVEYING CO.  
MEDFORD

6437

OREGON

SURVEY NO. 6437

SURVEY NARRATIVE TO COMPLY WITH O.R.S. 209.250



SURVEY FOR: Robert Jenkins  
Myrtle Creek, Oregon

LOCATION: Northeast one-quarter ( $\frac{1}{4}$ ) of  
Section 22, Township 38 South,  
Range 1 East, Willamette Meri-  
dian, Jackson County, Oregon.

PURPOSE: To set the North 1/16 corner  
between Sections 22 & 23,  
Township 38 South, Range 1  
East, Willamette Meridian

PROCEDURE: Traversed from East one-quarter  
corner to the Northeast corner of  
Section 22 and set the 1/16 corner  
at the mid-point on true line.  
Used E.D.M. equipment and one-  
second theodolite.

DATE: July, 1976

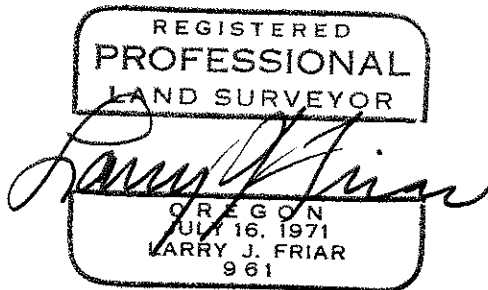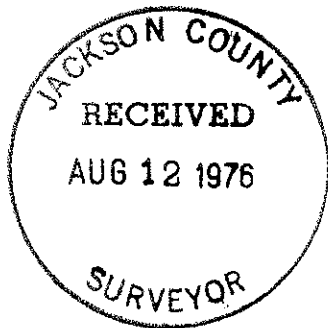

Larry J. Friar  
Professional Land Surveyor